


SECTION

TOWNSHIP 20 S, RANGE 9 W., W. M.

North

APR 24 1936

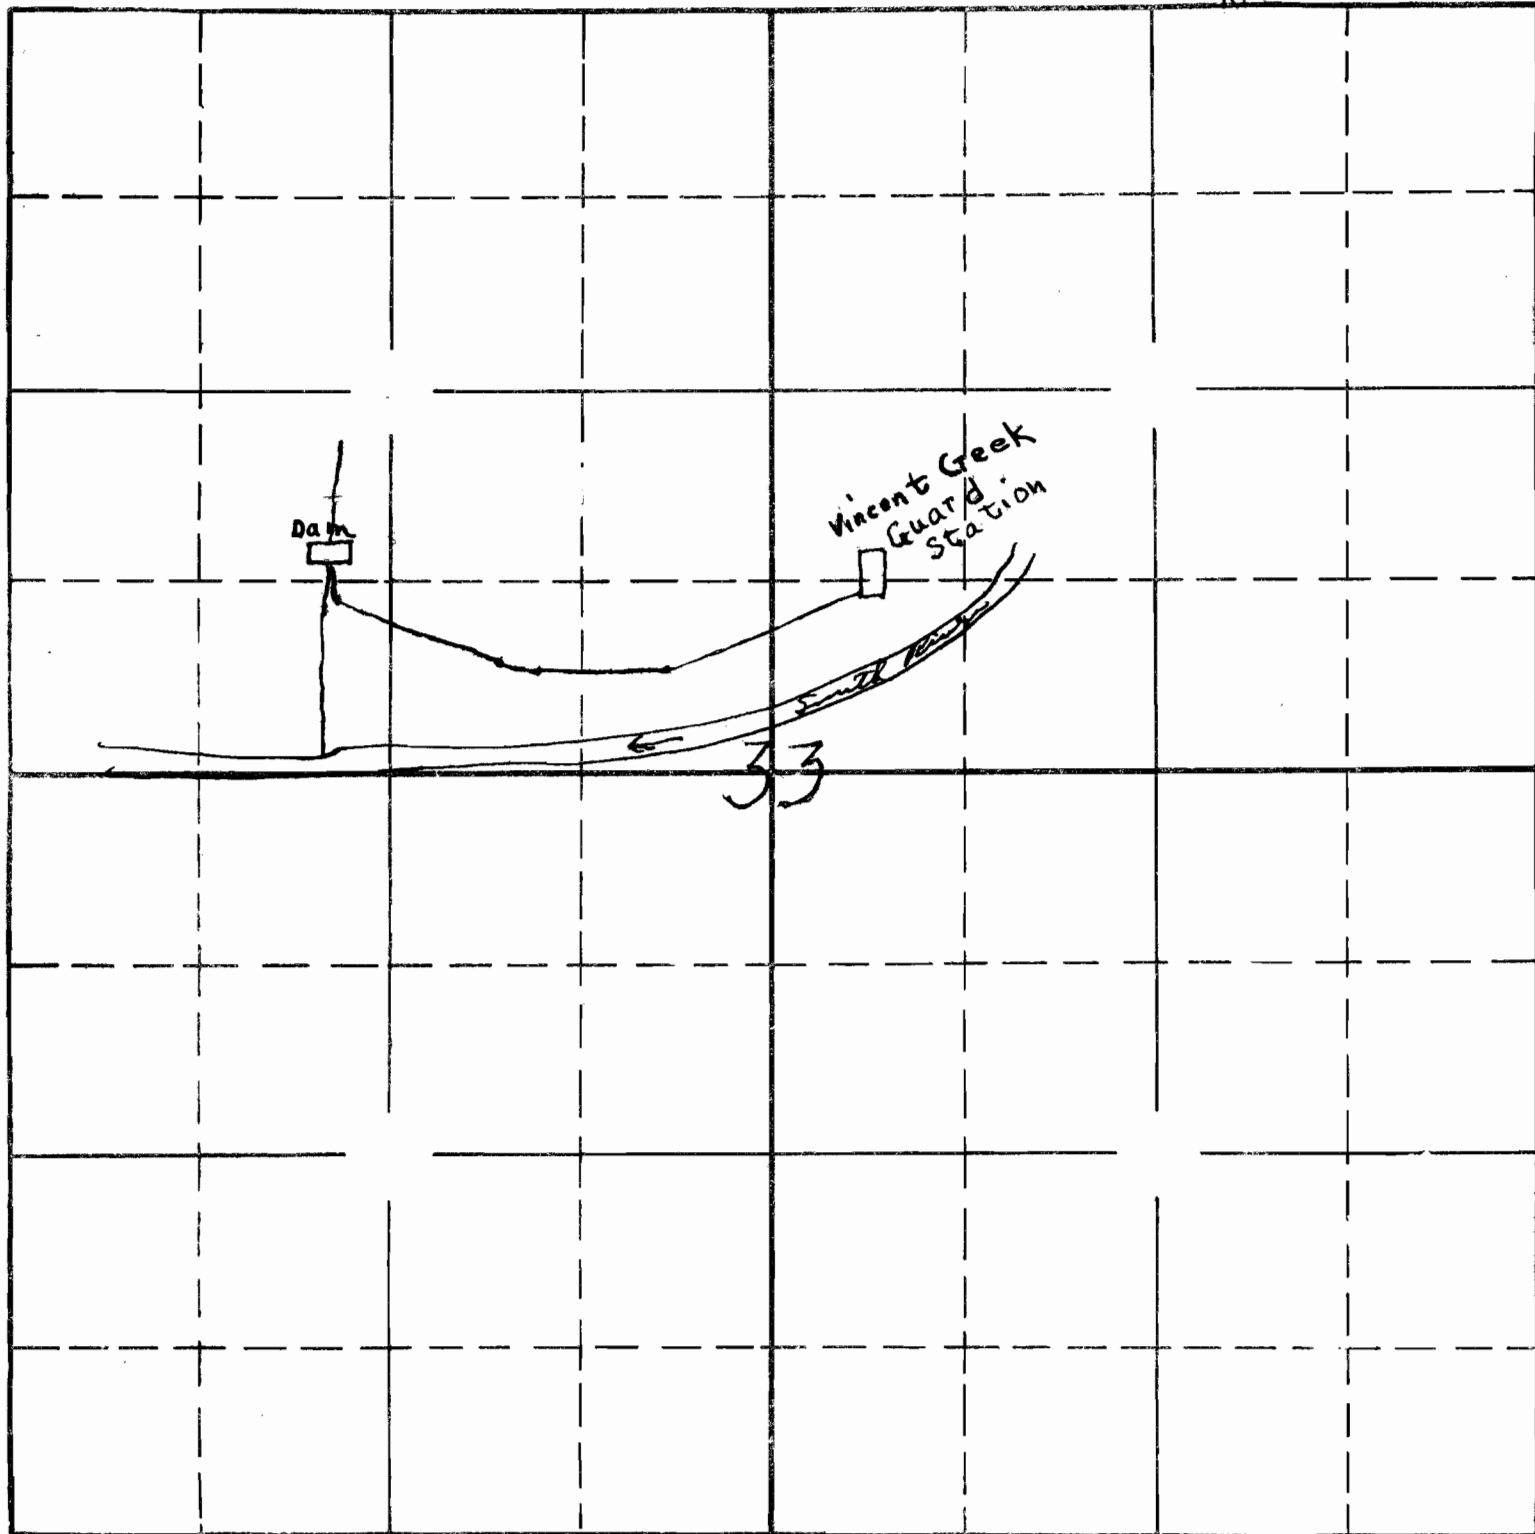

16362
 APPLICATION No. 16362
 PERMIT No. 12170