


T. 36 S. R. 22 E. W.M.

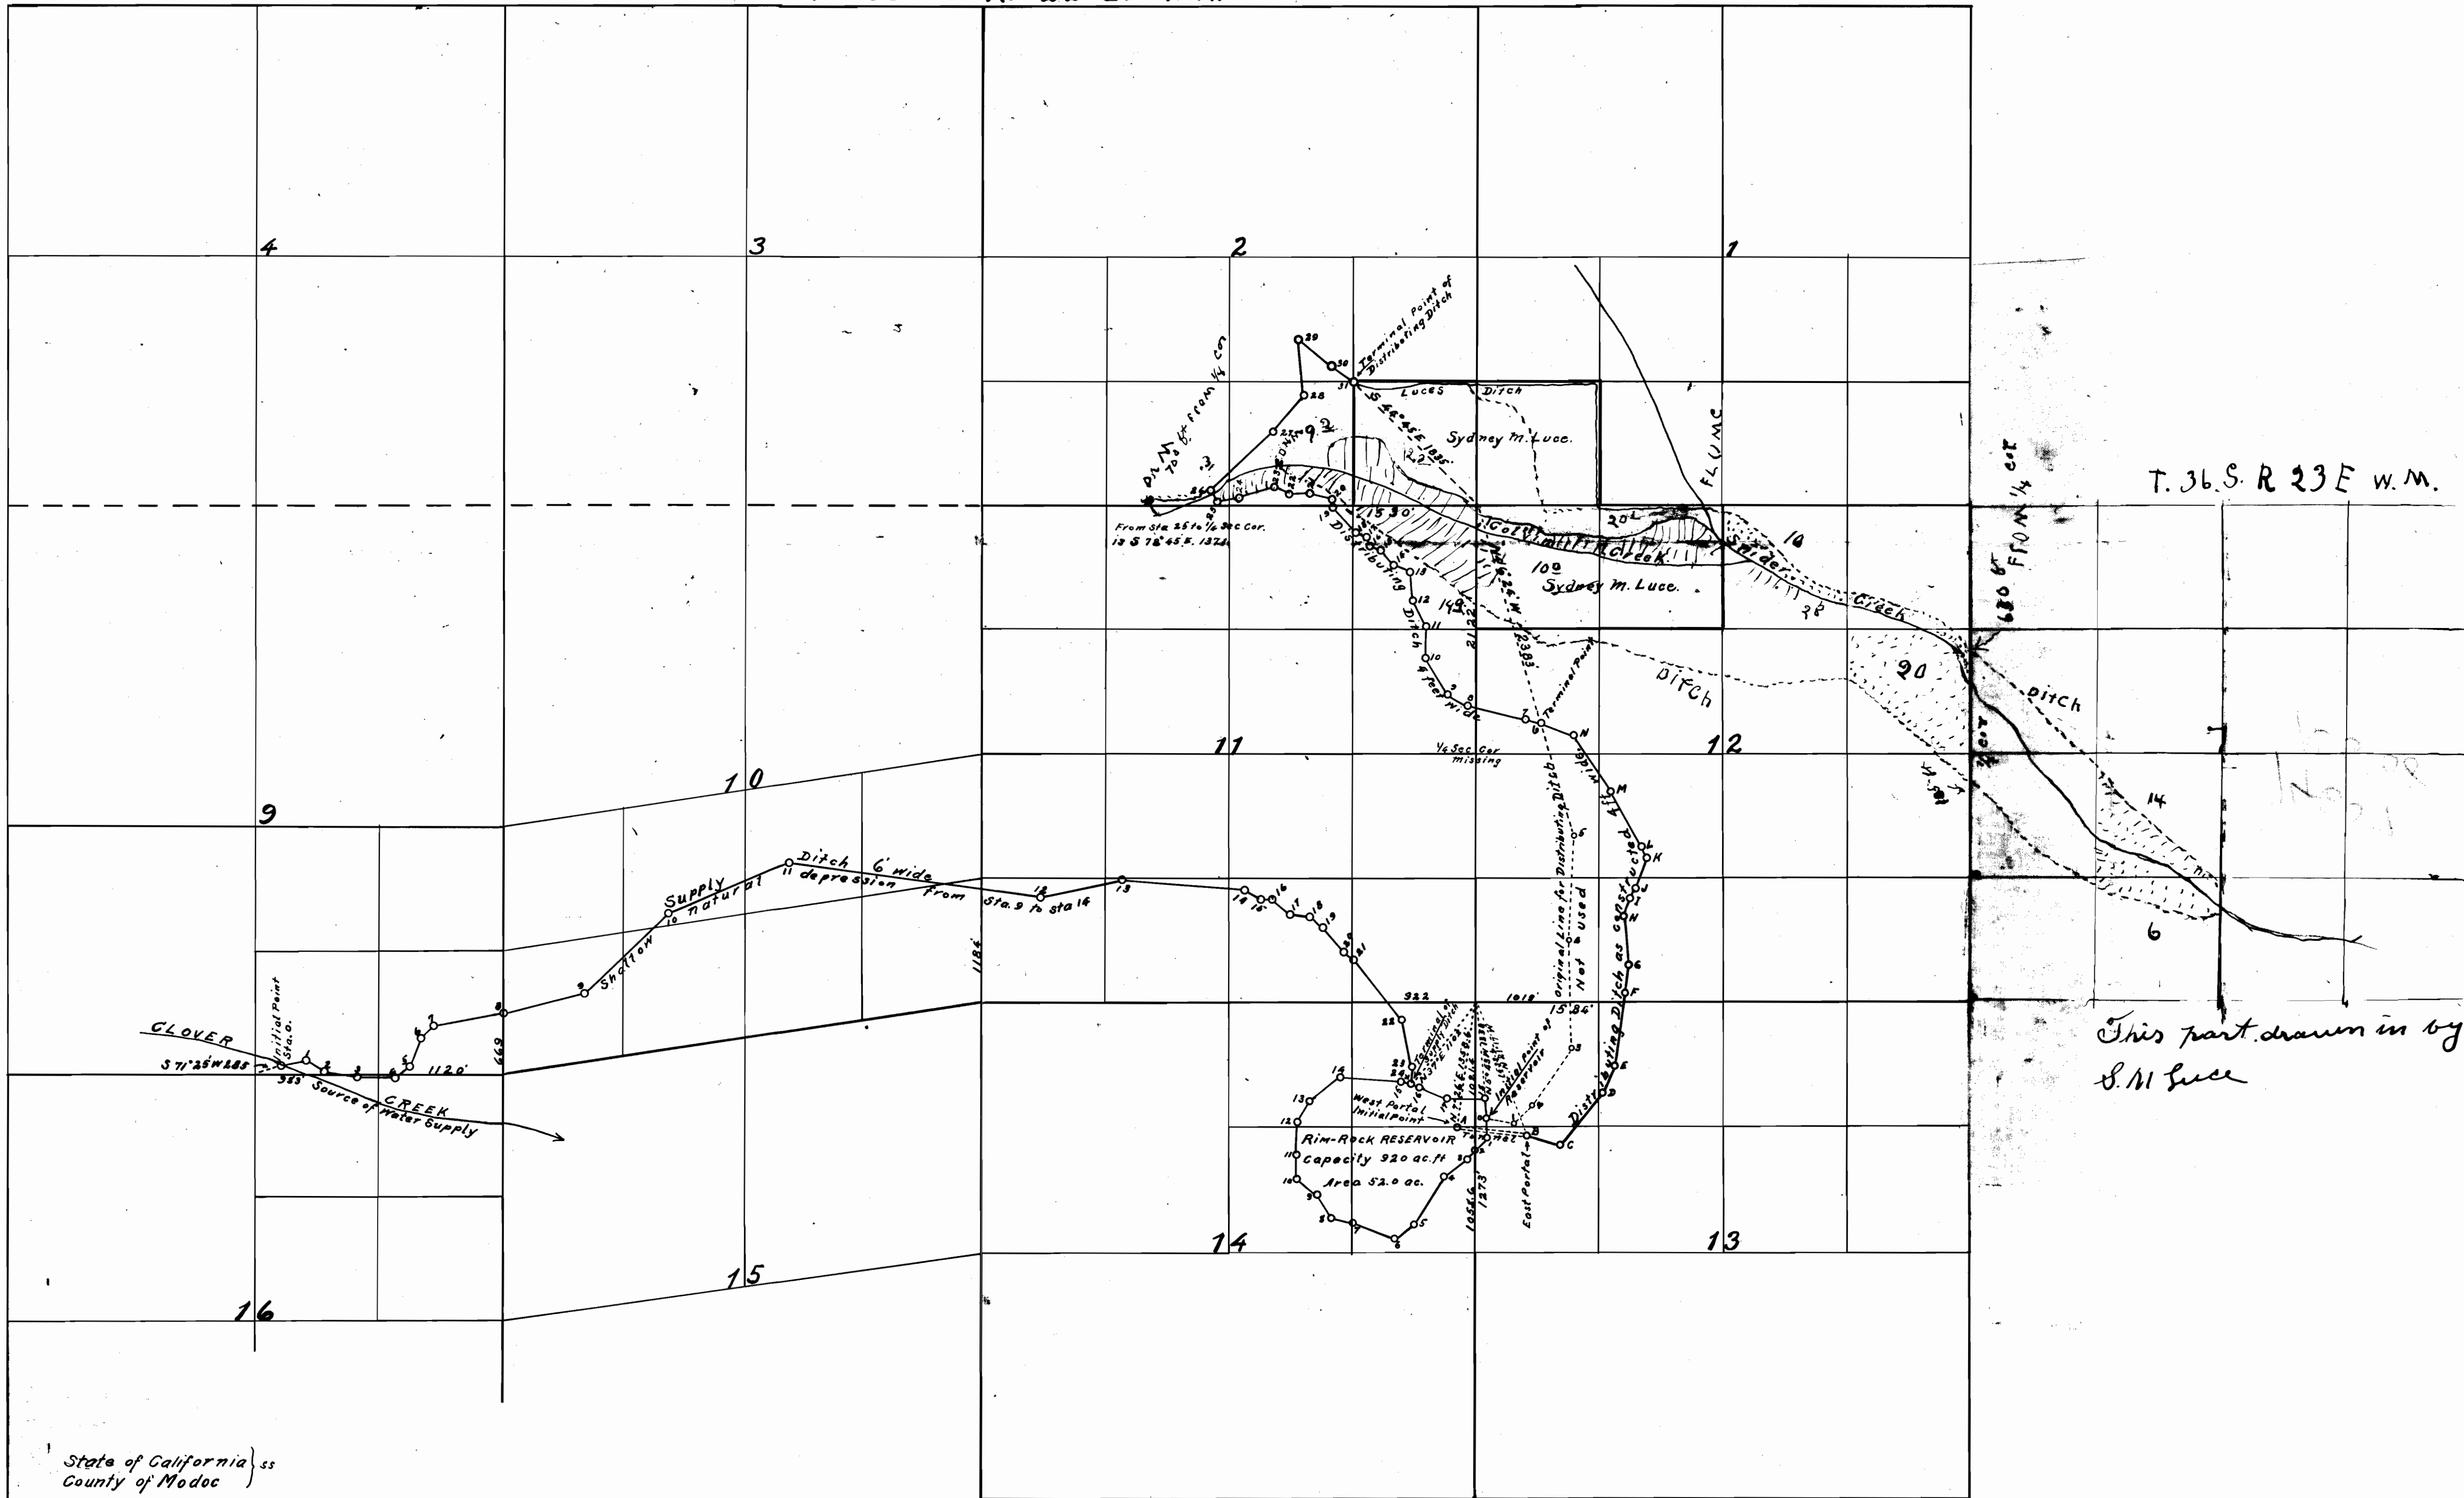

T. 36 S. R. 23 E. W.M.

This part drawn in by
S.M. Luce

State of California } ss
County of Modoc

I, Geo. T. Cline, being first duly sworn, depose and say, that the above map is a true and accurate tracing of the original, amended map of Rim-rock Reservoir and Ditches, which was taken from the field notes of surveys made by me on the 24th, 25th and 26th days of October and the 5th day of November, 1914 and the 8th day of October 1926; and that said original map was filed in an application for right of way for said reservoir and ditches.

Geo. T. Cline, Surveyor

Subscribed and sworn to before me this 1st day of July 1932.

J. T. Sharp
Notary Public in and for
Modoc County, California.

MAP OF AMENDED DEFINITE LOCATION
OF
RIM-ROCK RESERVOIR AND DITCHES

Scale - 1 inch = 1000 feet.

Application No. R-14607-14608
Permit No. R-655-9-
10627

STATE ENGINEER
RECEIVED
JUL 5 1932
SALEM, OREGON