


Map Showing Intake and
 Location of Approx. 30 A Land
 For Vic Butler Sec 20 T 14 R 14 E
 Scale 2"=1M.

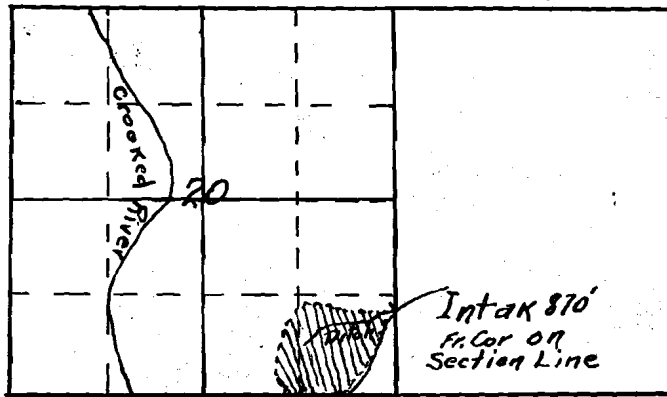

7A. in SW $\frac{1}{4}$ SE $\frac{1}{4}$
 23A SE $\frac{1}{4}$ SE $\frac{1}{4}$

Application No. 12658
 Permit No. 8998

P# 8998

C11698

Permit No. 8998