11740
T 7312

OK

Twp 14 S R 16 E

Twp 14 S R 17 E W M

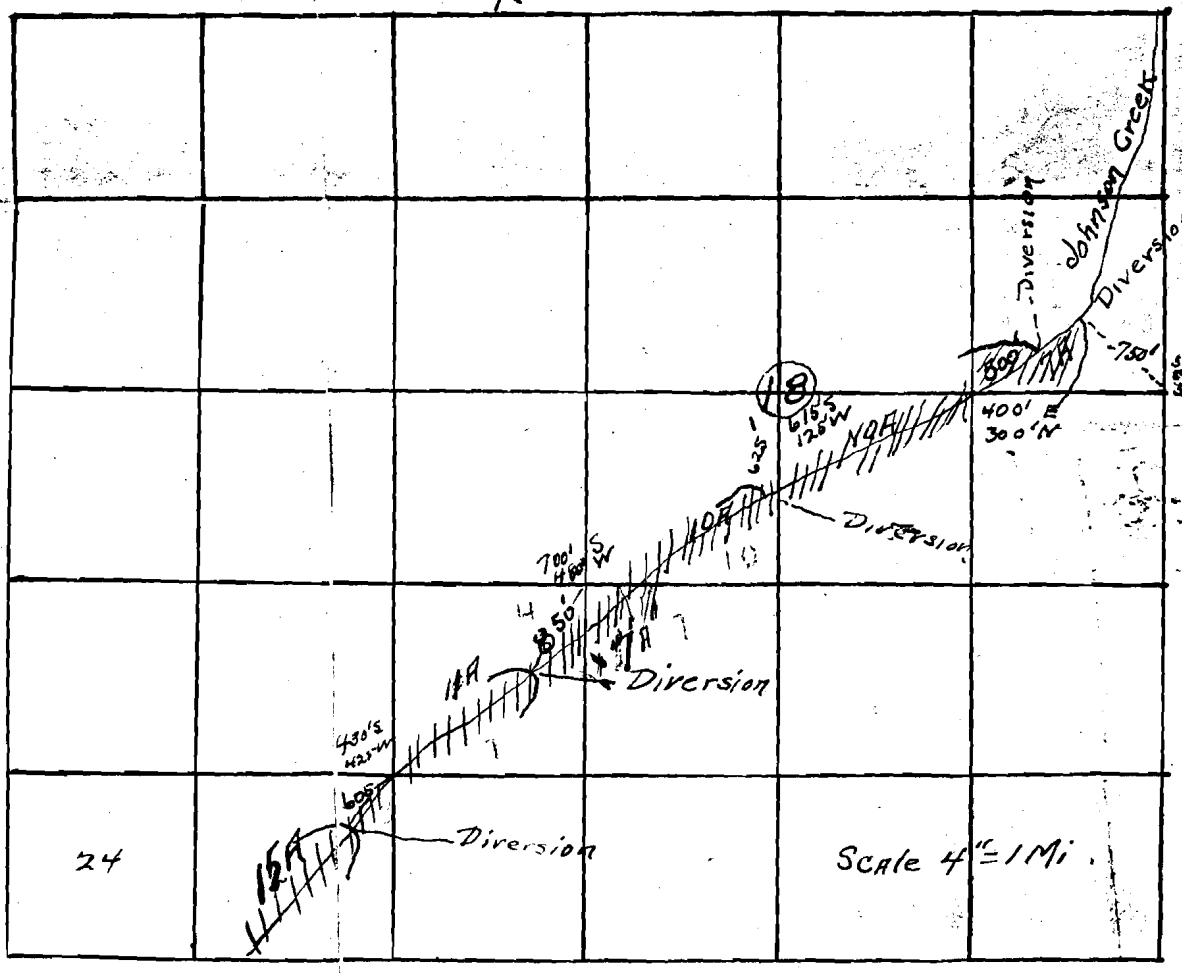

15784
App. No.
Per. No.
11643