


SECTION

TOWNSHIP 45, RANGE 3E, W. M.

North

East

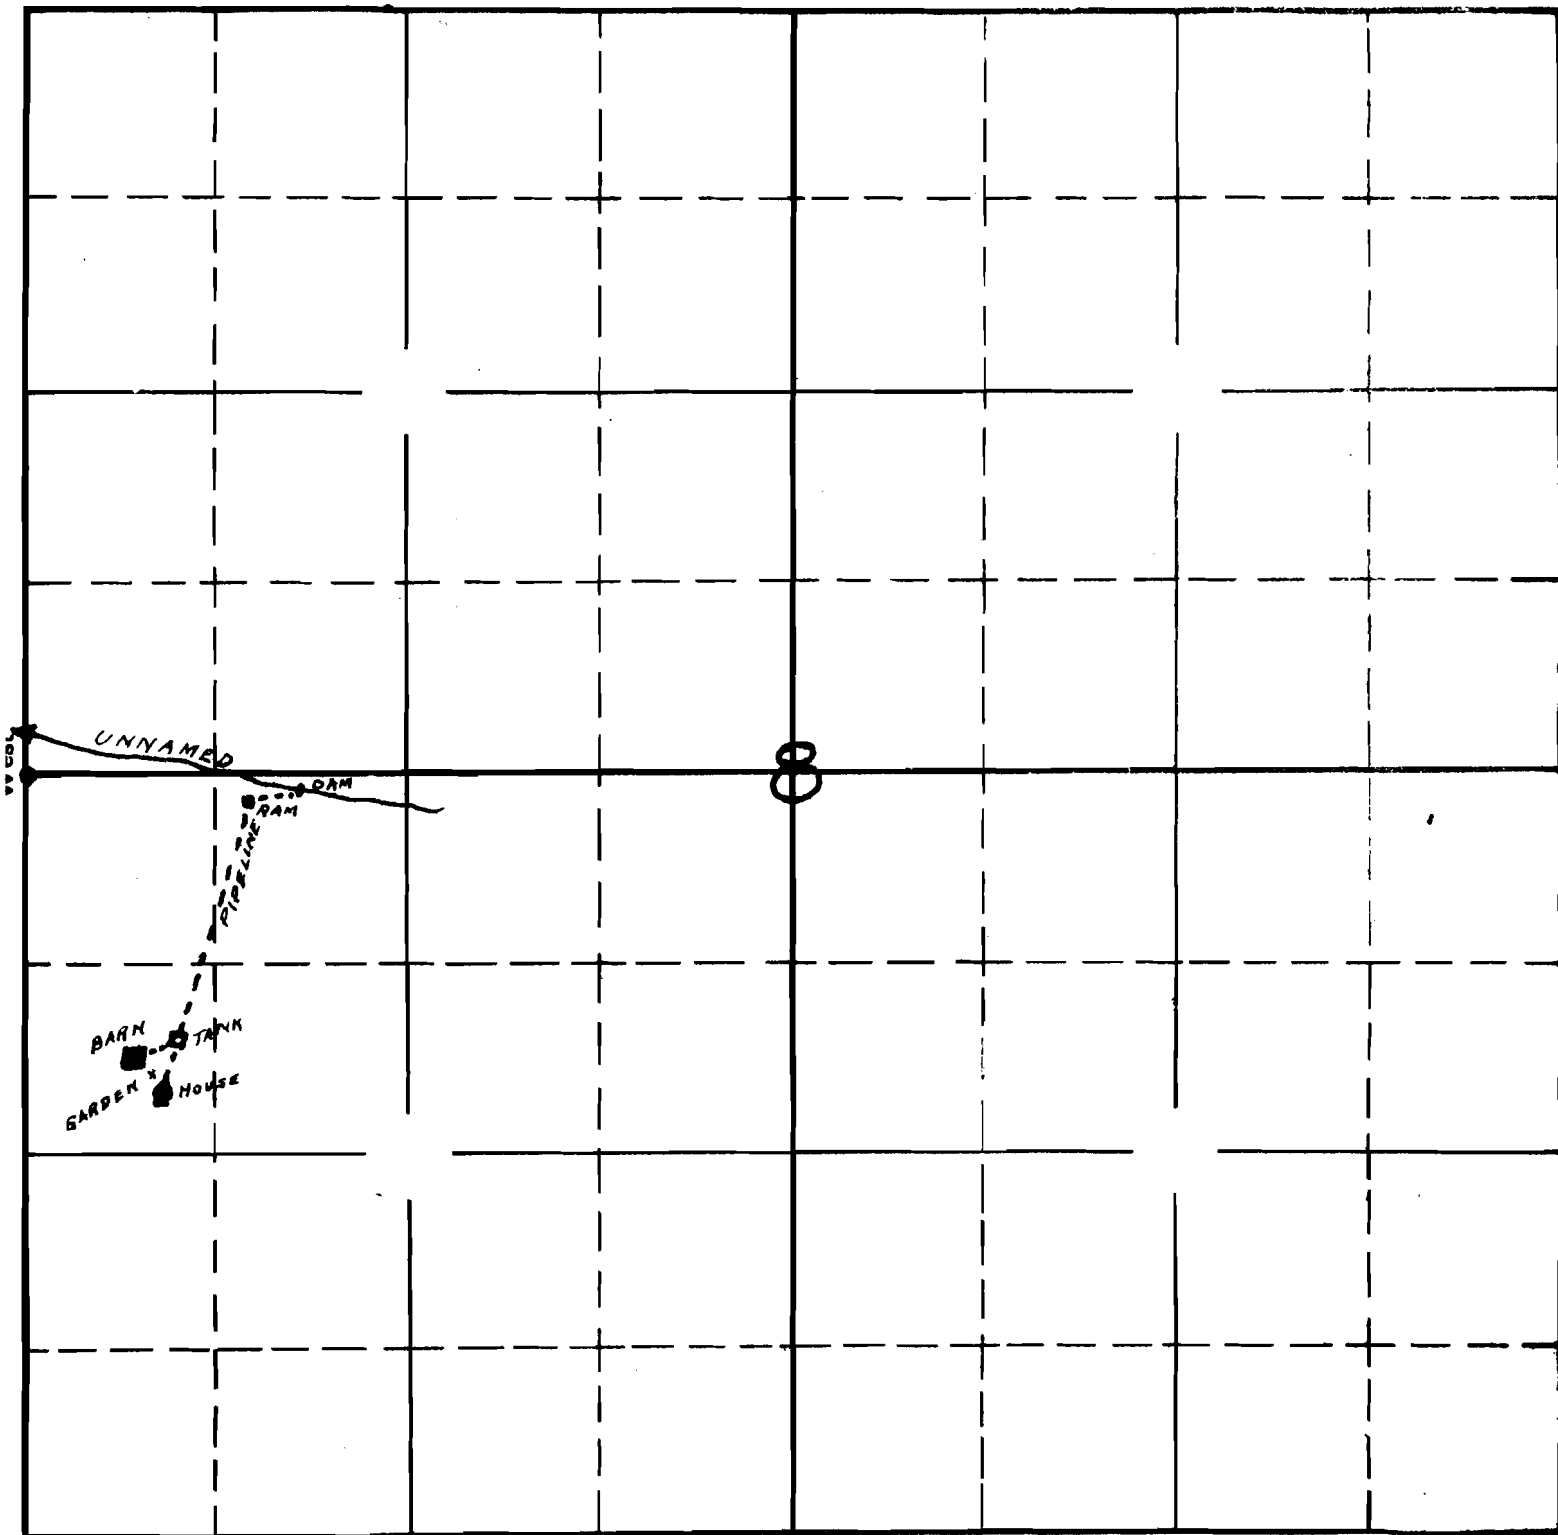

South

Copied from applicant's
sketch- 6/28/35-

2-11-15908
APPLICATION No. 15908
PERMIT No. 11745