


SECTION

Per 11835

11747

TOWNSHIP 95, RANGE 30E W. M.

North

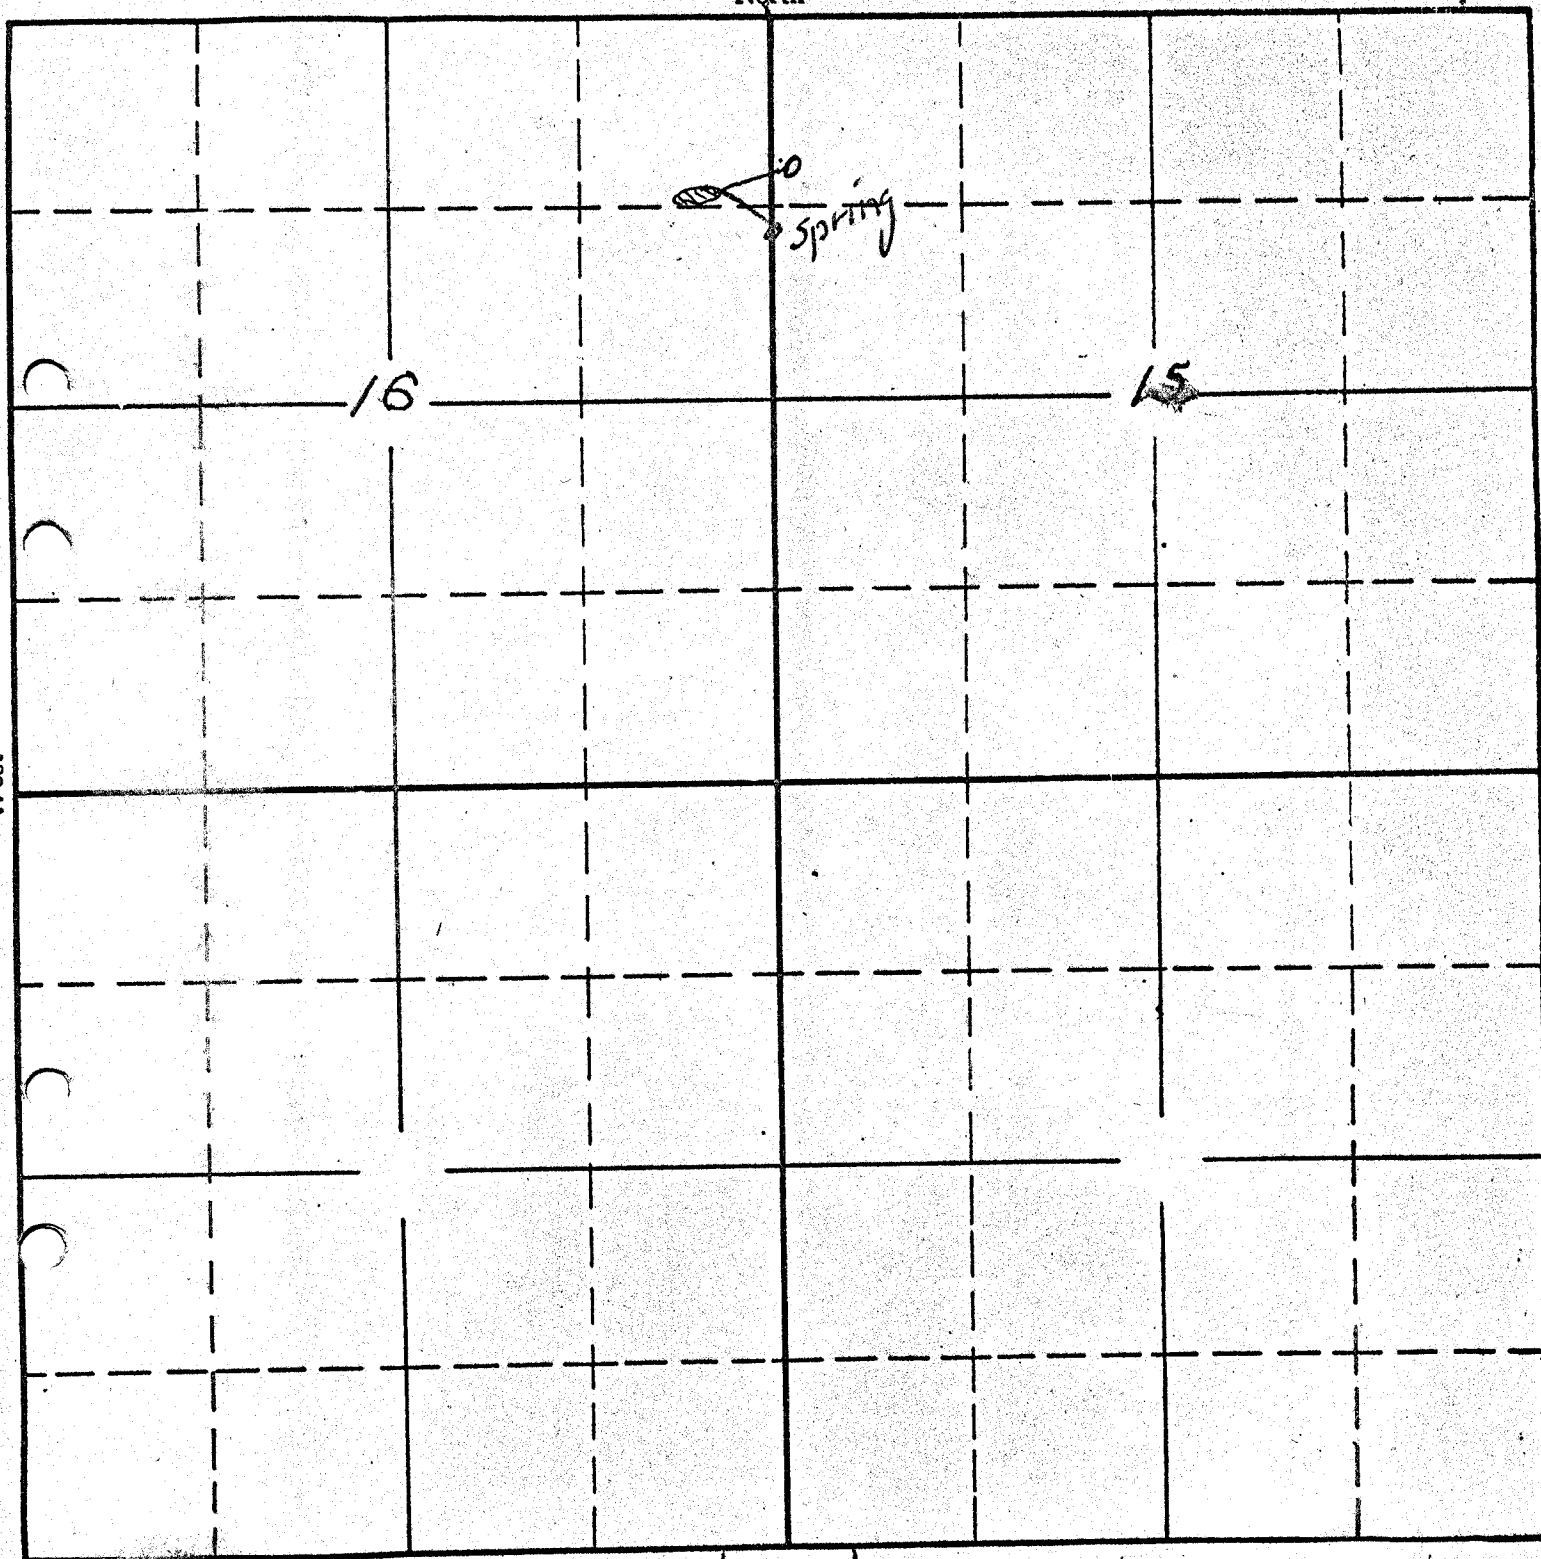

RECEIVED
AUG 15 1935

STATE ENGINEER
SALEM, OREGON

See corrected South
maps attached
to proof -

6-26-15992 OK
APPLICATION No. 15992
PERMIT No. 11835