


Sections 2, 10 + 11 - Township 15 S, R. 10 E, W. M.

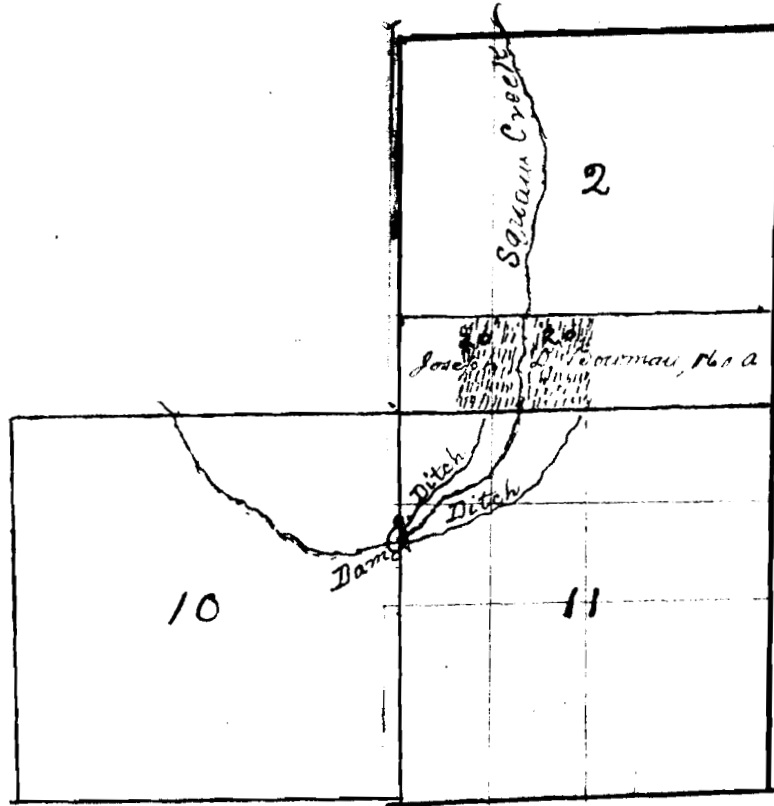

~~~~~ Sawain Creek  
 ——— Ditch  
 ——— Ditch  
 [Hatched] To be irrigated  
 [Circle] Dam

3380

3380

OFFICE OF STATE  
**RECEIVED**  
 JAN 8 1914  
 SALEM, OREGON,

Application No. 3380  
 Permit No. 1889

3380

C 1175

1889