

UNITED STATES DEPARTMENT OF AGRICULTURE  
FOREST SERVICE


MAP SHEET

No. Rogue River National Forest.

Division \_\_\_\_\_ District \_\_\_\_\_, Block \_\_\_\_\_

T. 32 S., R. 2 E., W. \_\_\_\_\_ M., Section 17, Quarter S.W.

Mapped by J.P. DeWitt Scale: 16 inches = 1 mile.

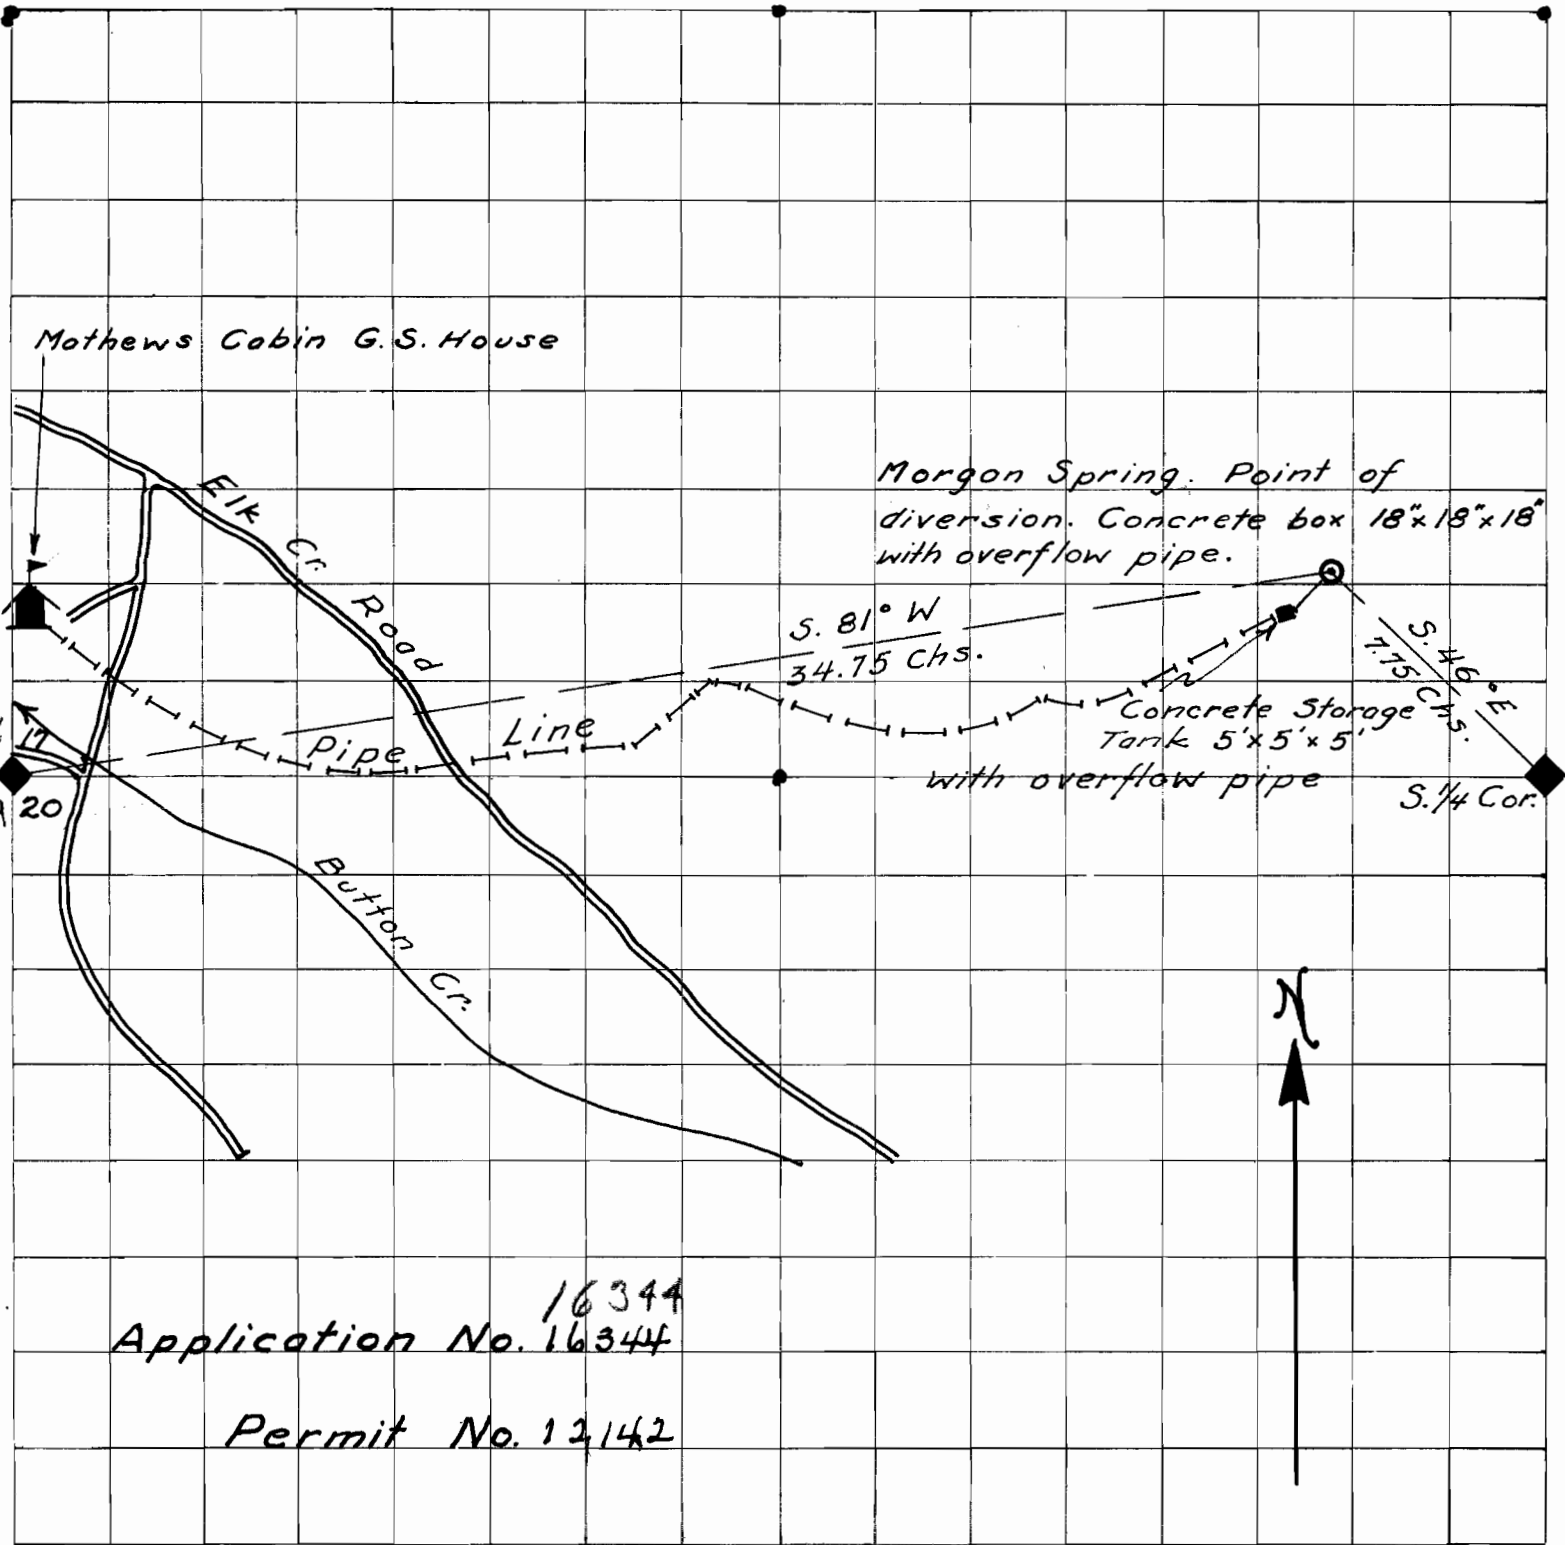

Application No. 16344

Permit No. 12142