

SECTION


11

12293

11768

TOWNSHIP 27S, RANGE 8E, W. M.

North

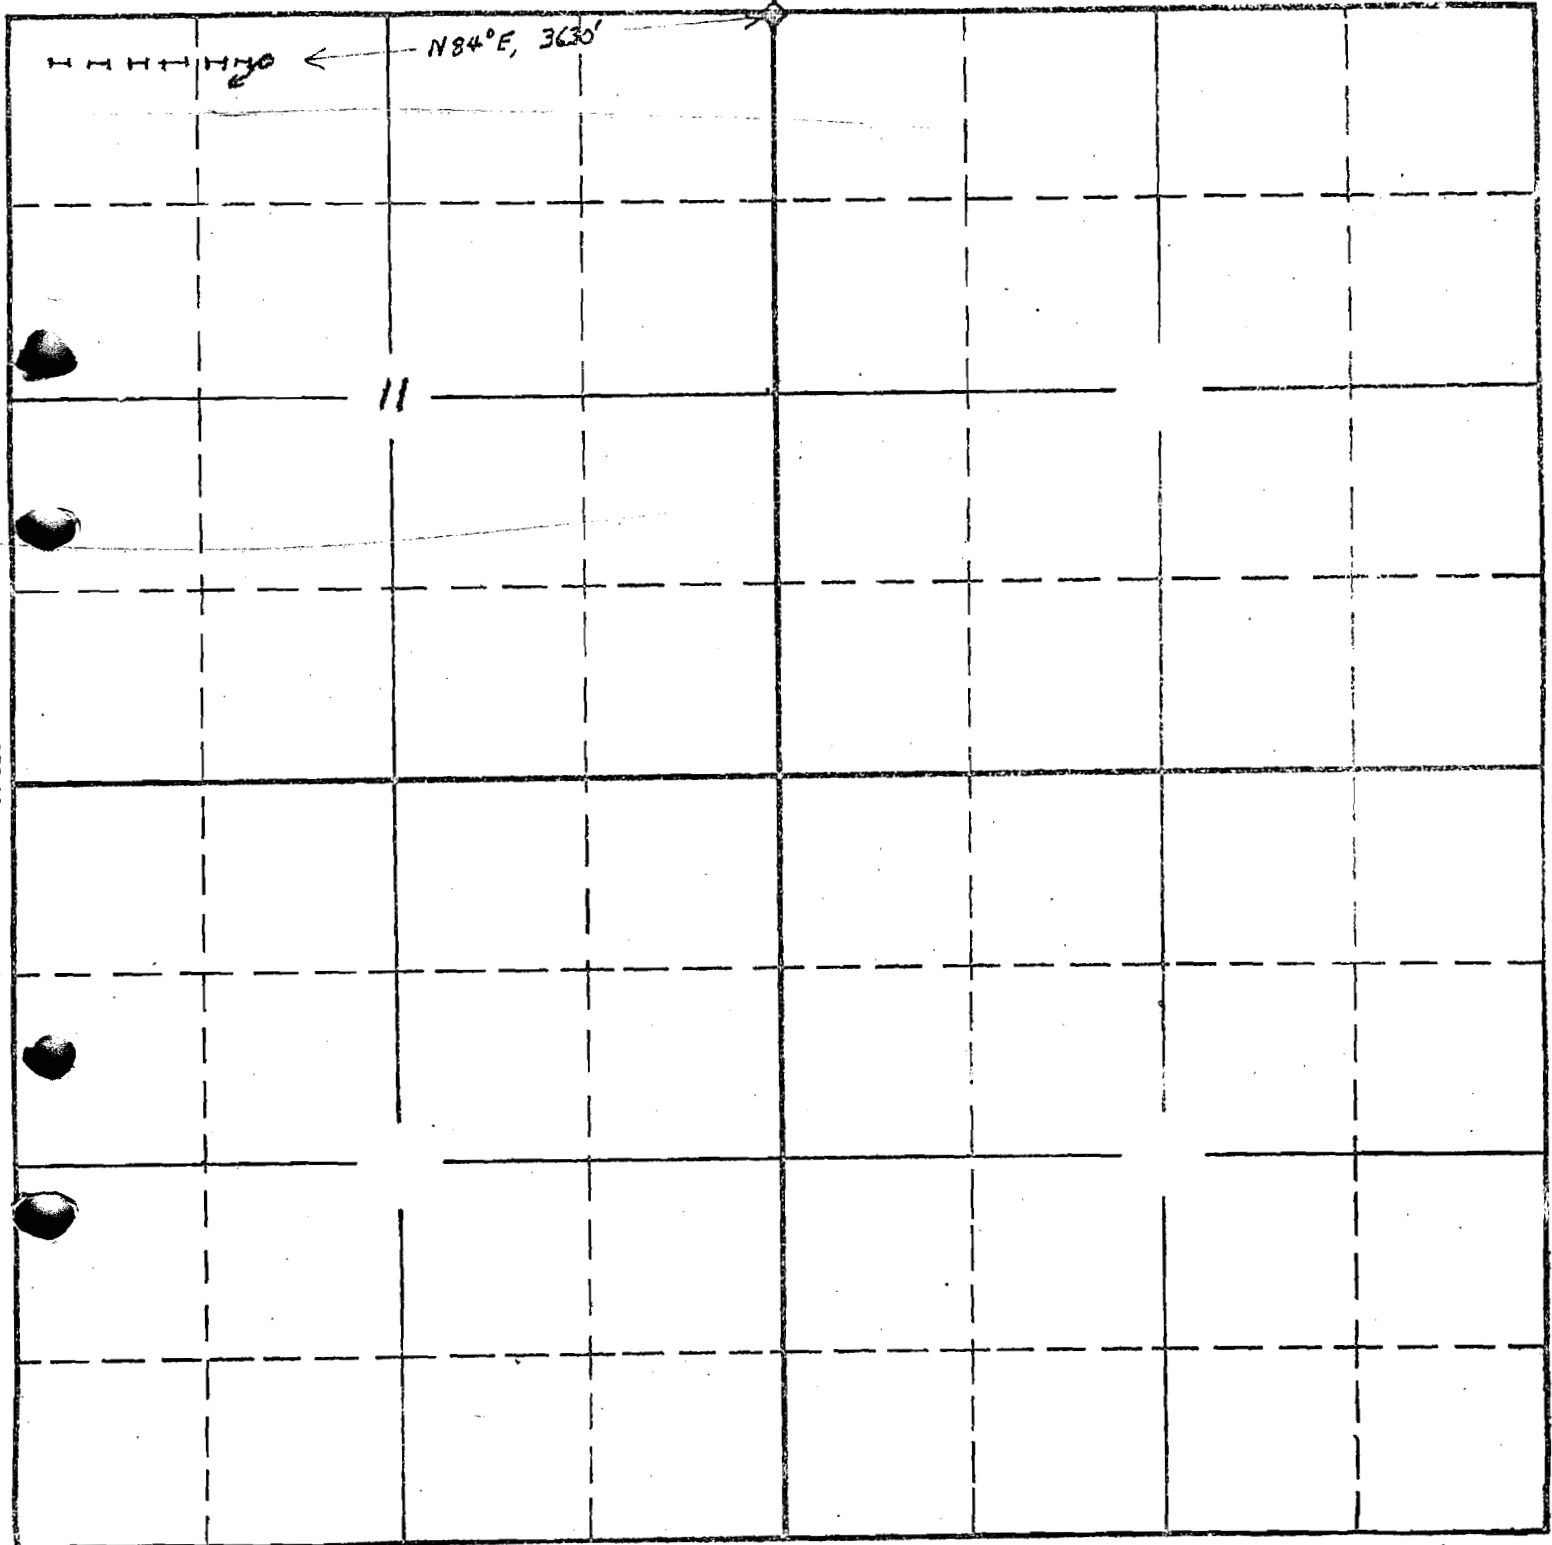

South

5-20-16492 *OK*
APPLICATION No. 16492
PERMIT No. 12293