


SECTION

12338
11773

TOWNSHIP 40S, RANGE 19E, W. M.

North

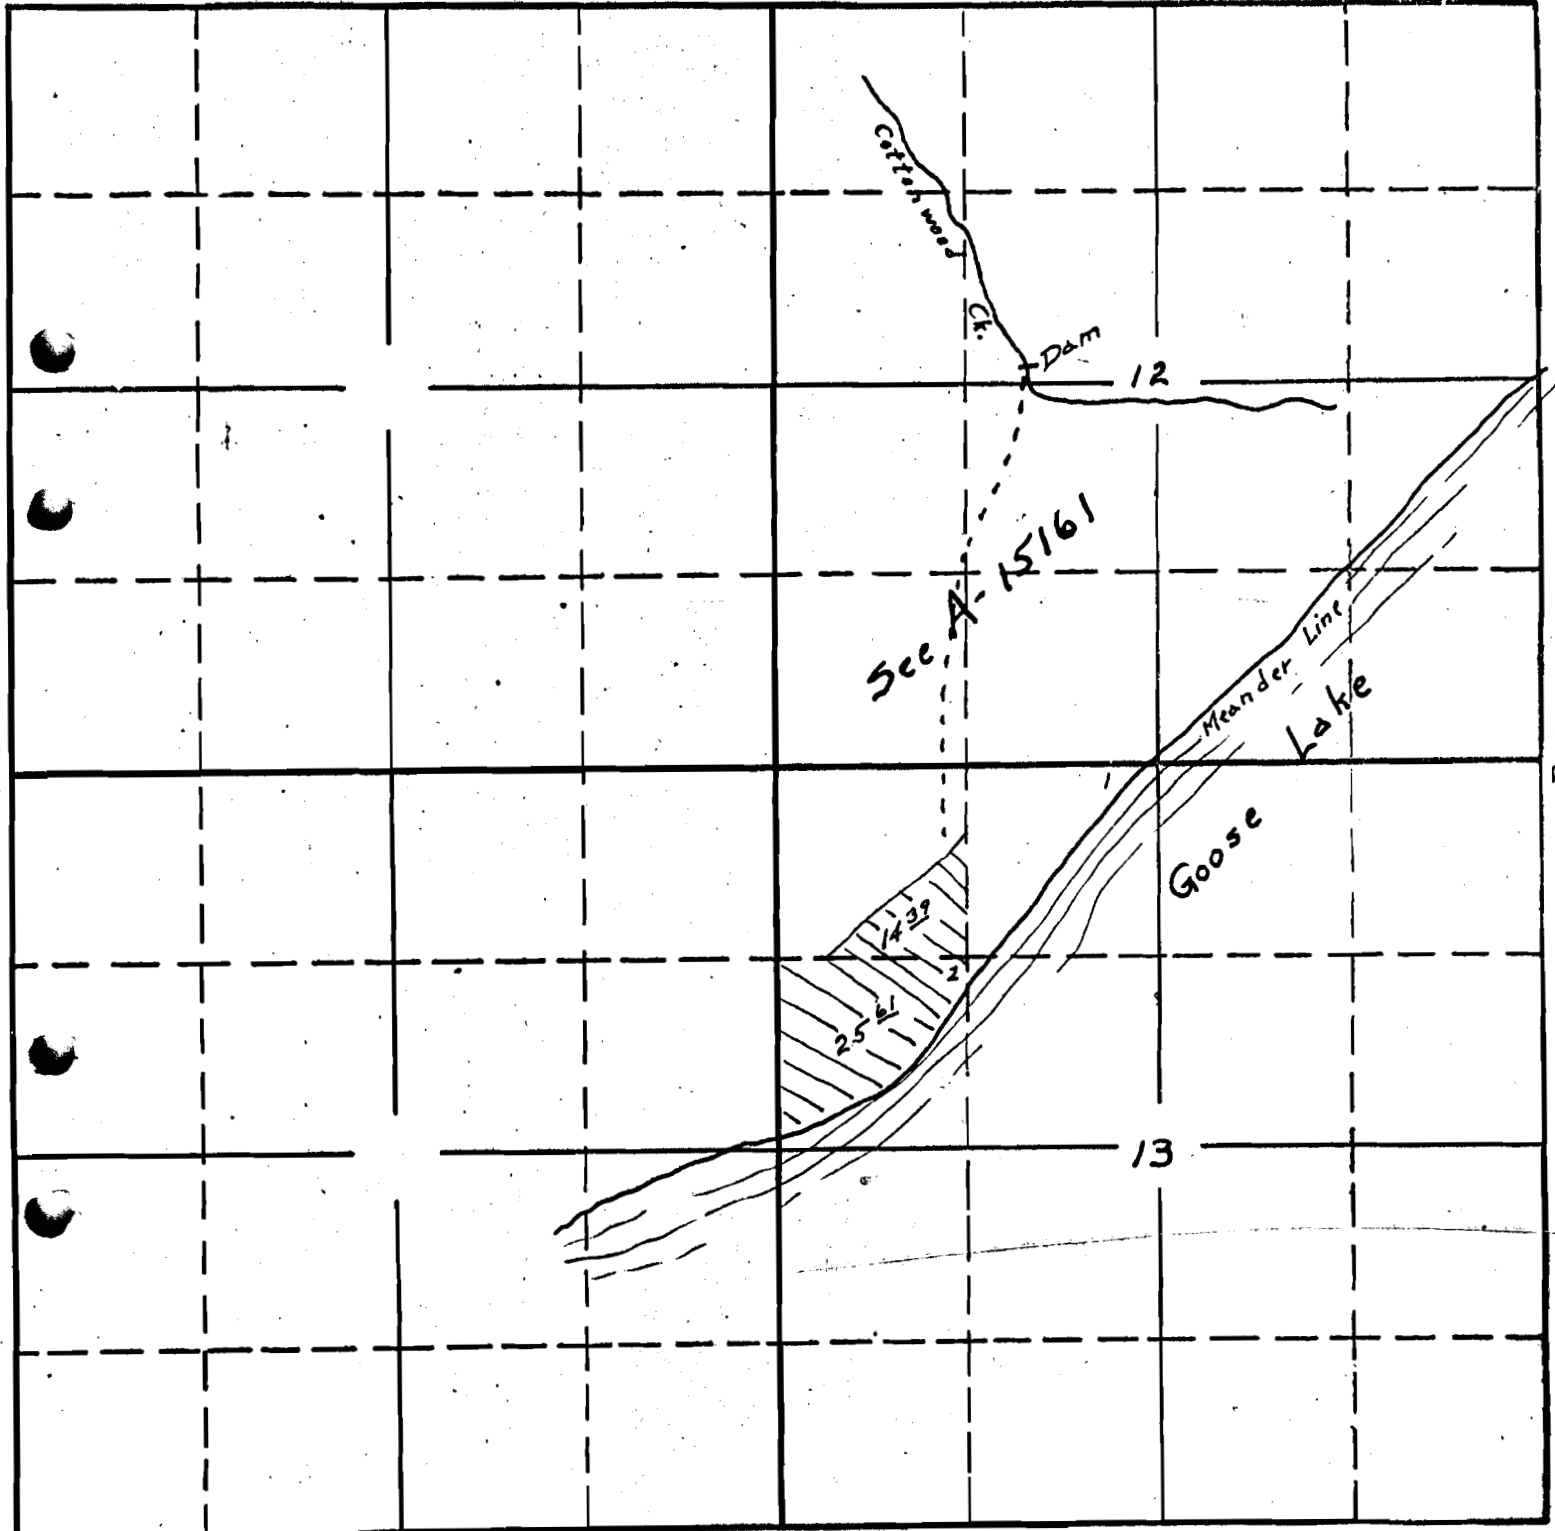

South

16548
APPLICATION No. 16548
PERMIT No. 12338