


N.
↑

NW^{1/4} Sec 31, 3 T₂ S 11 E W. 22.

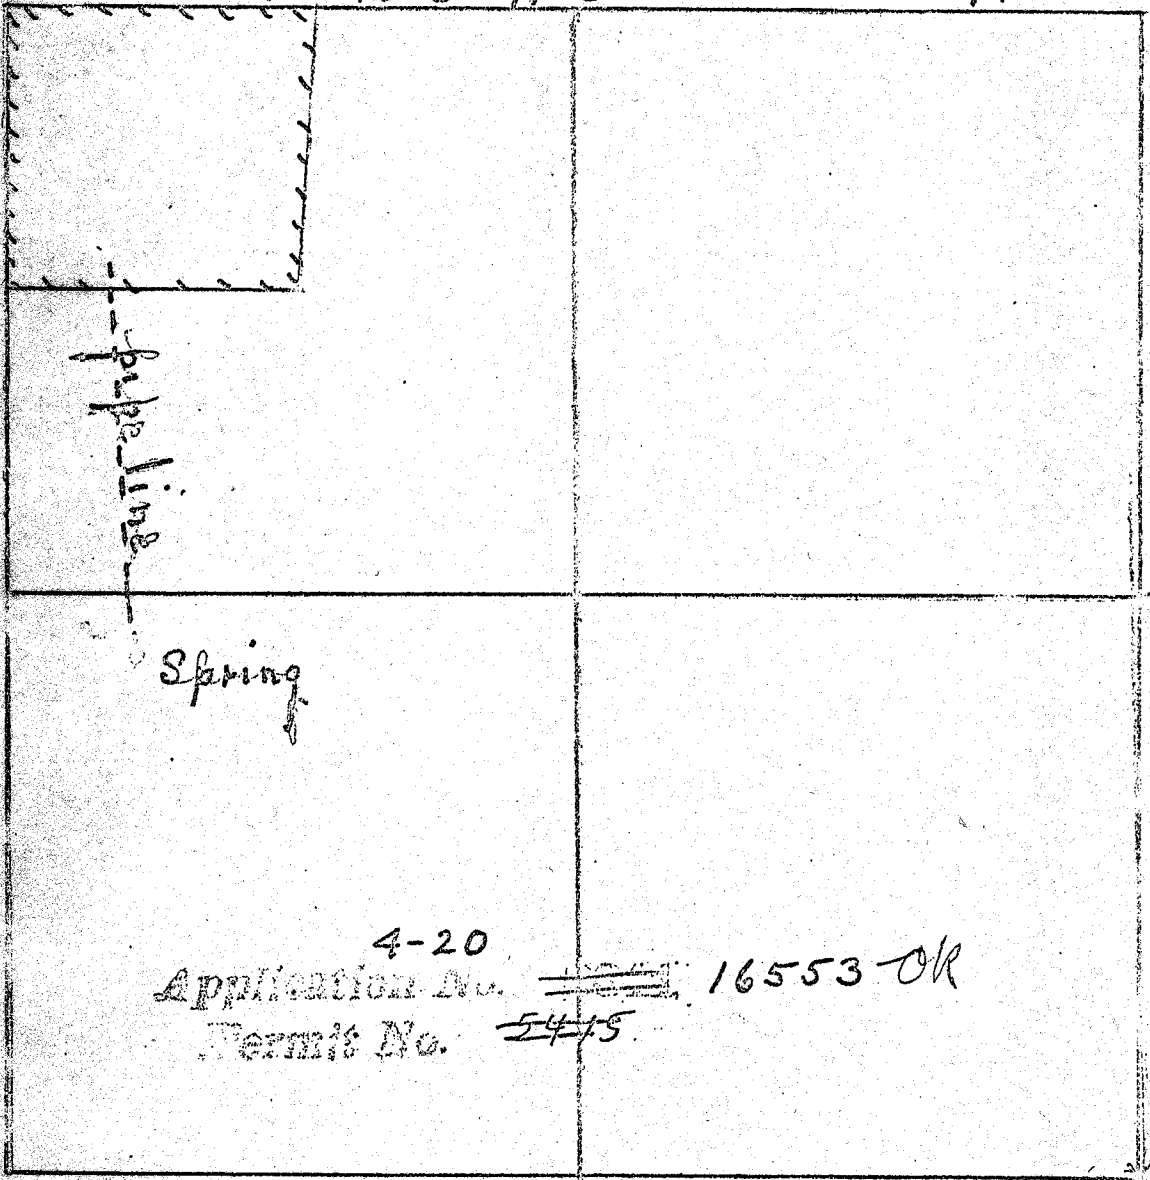

* Center
31 Acre

App. No. 16553

Per. No. 12242