


U-72

RECEIVED  
STATE OF OREGON  
East

Township 1 North South, Range 15

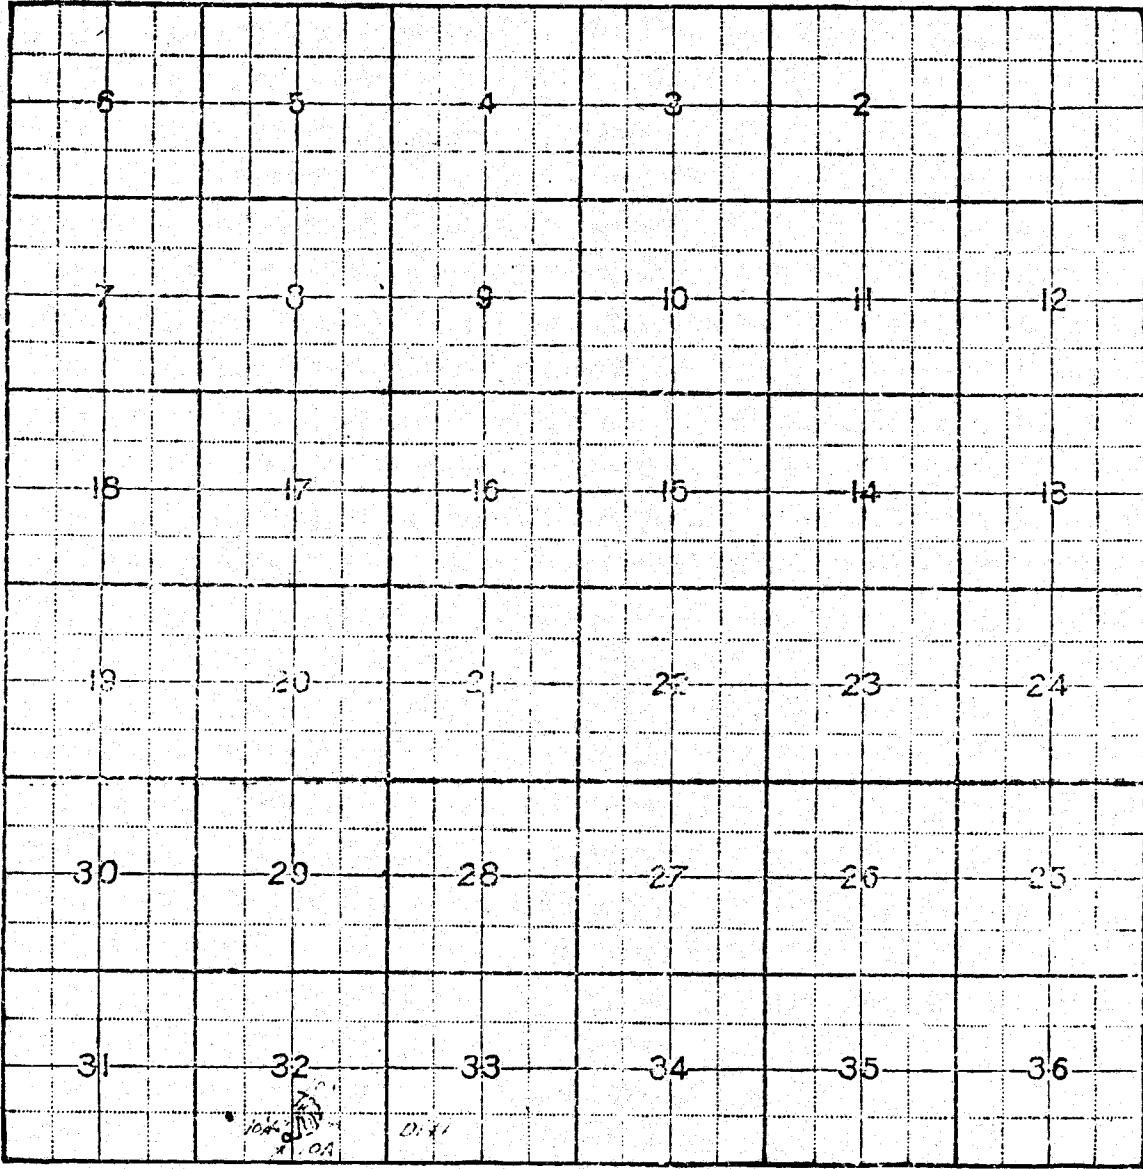

App. U-61  
Permit U-72

PDU is around  
farmstead buildings  
see Emerson Quad