


SECTION

TOWNSHIP 38 S, RANGE 1 E, W. M.

North

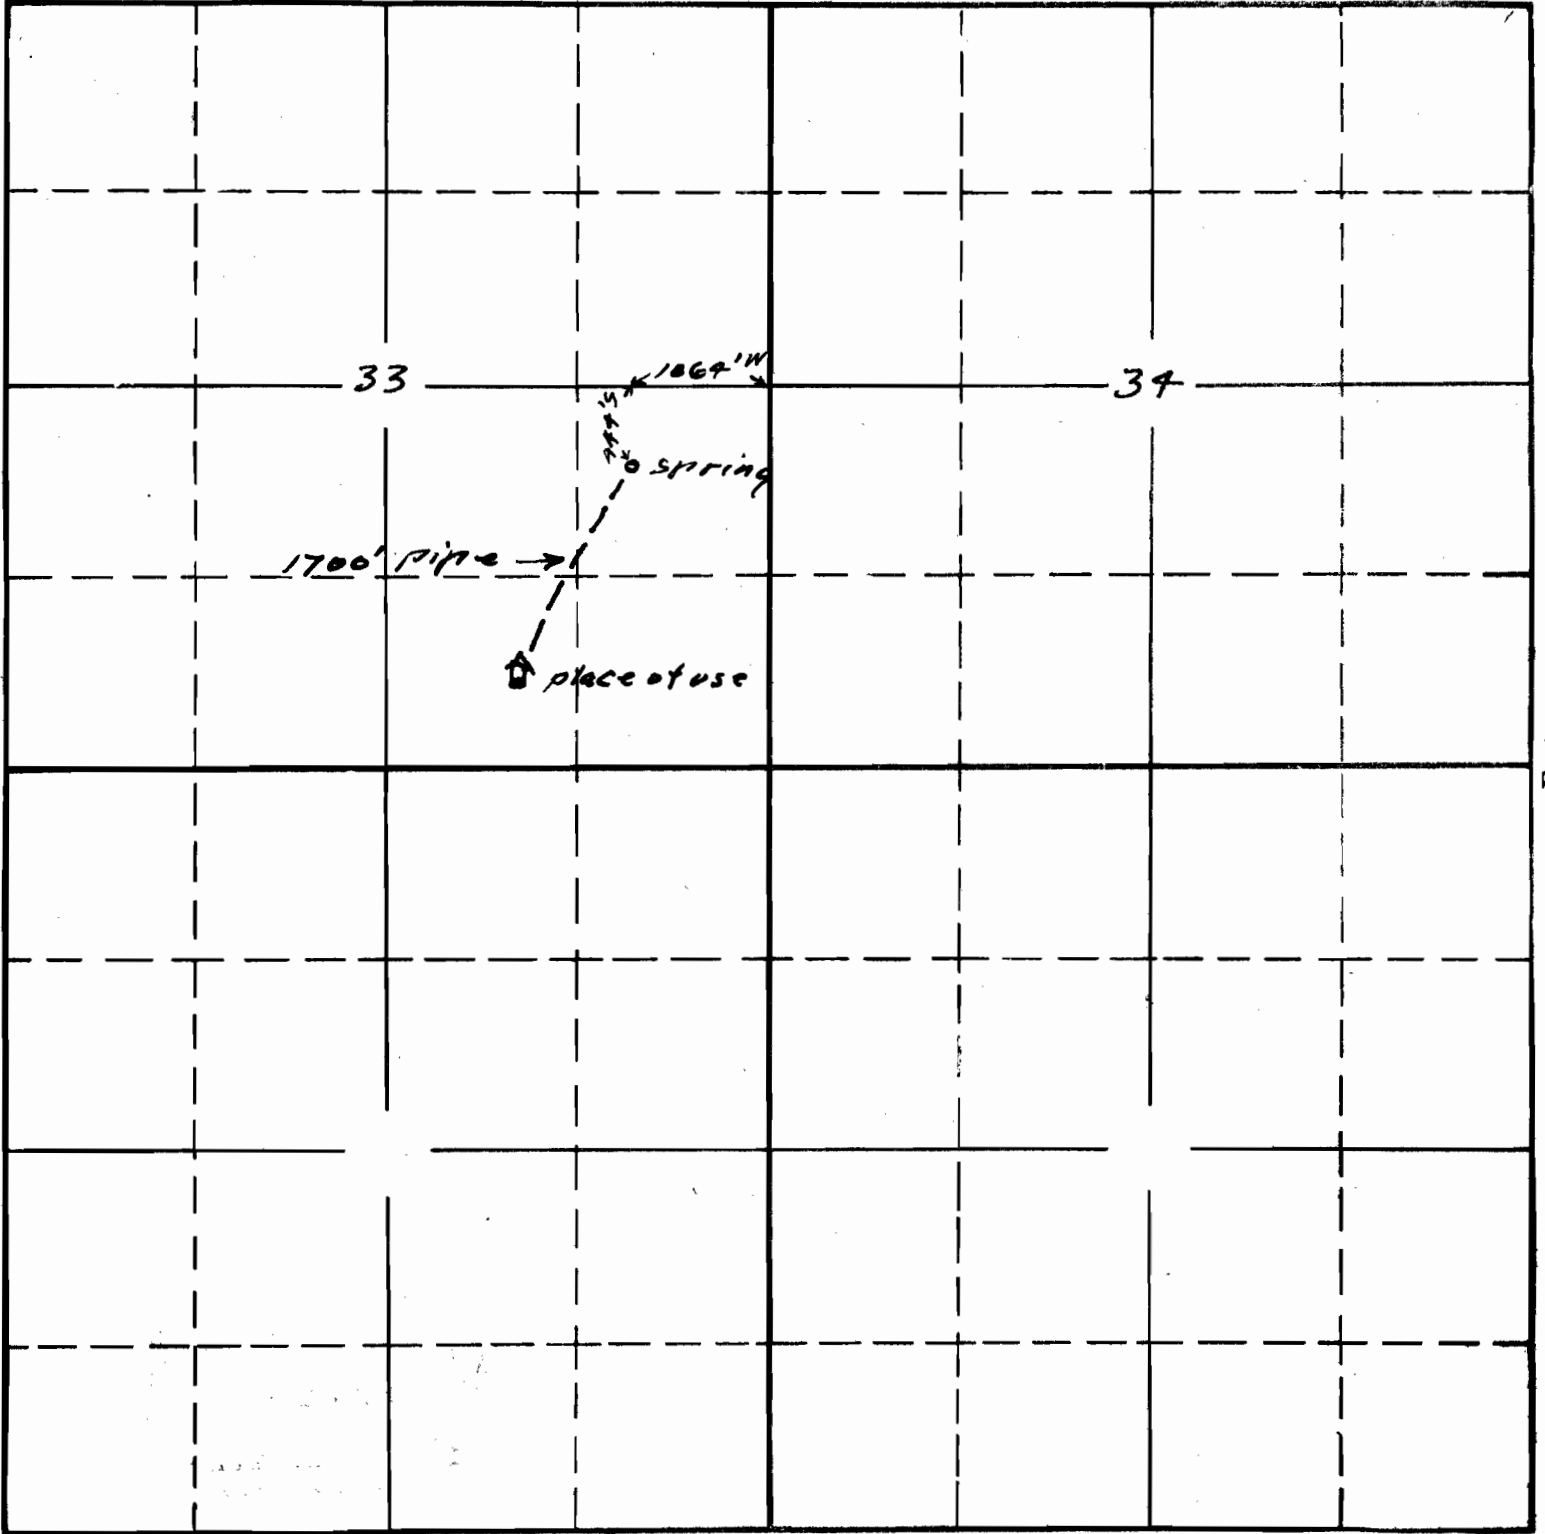

South

Sketch made from notes furnished by Engr F.H. Walker of Ashland to accompany APPLICATION No. 16196 application of D.M. Lowe of Ashland Ore. PERMIT No. 12109 for use of private spring for domestic & lawn