


SECTION

TOWNSHIP 34S, RANGE 7W, W. M.

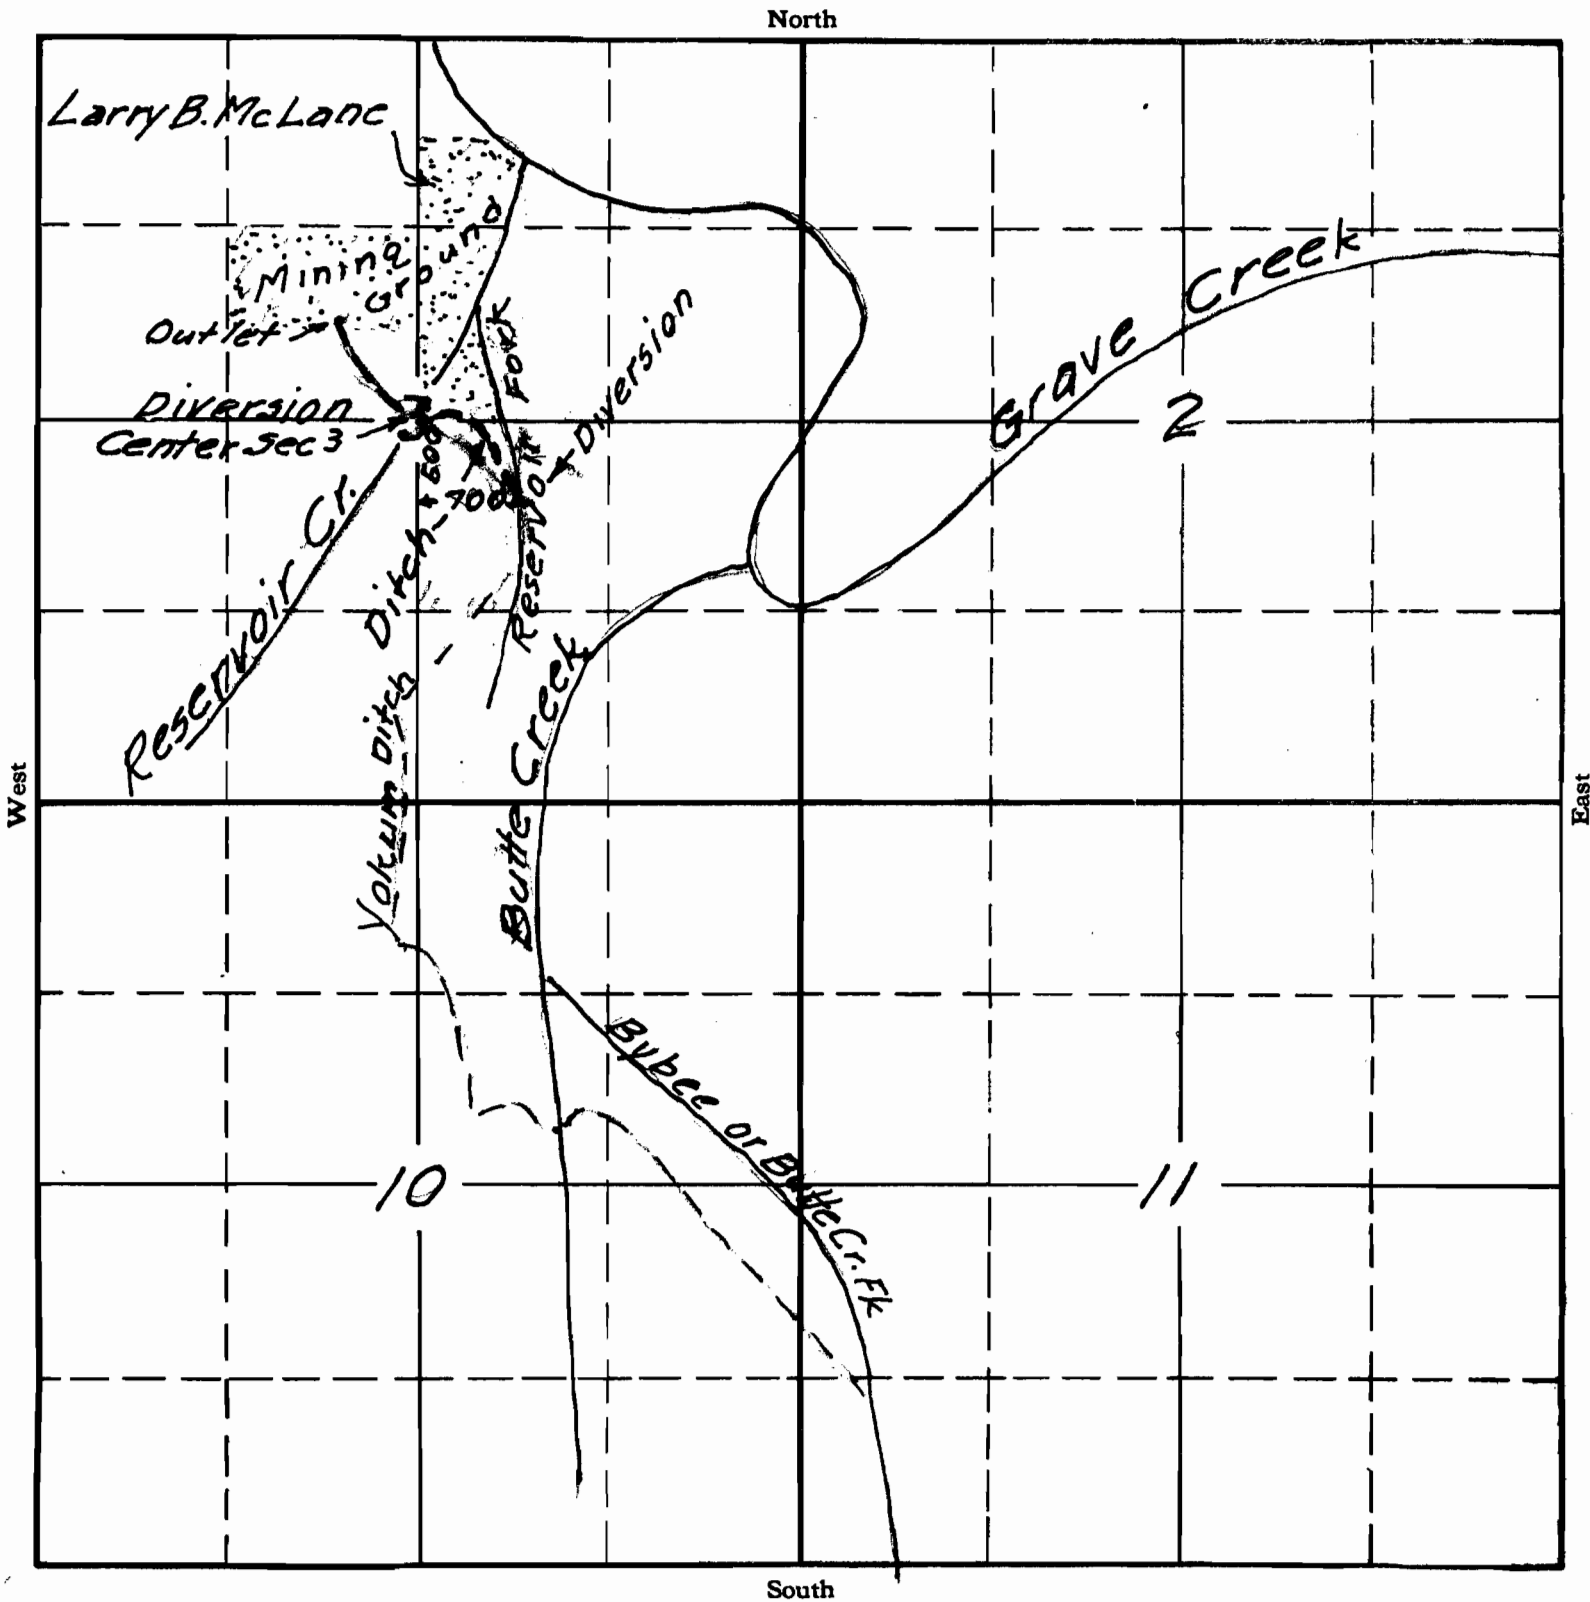

APPLICATION No. 15817  
PERMIT No. 11675