


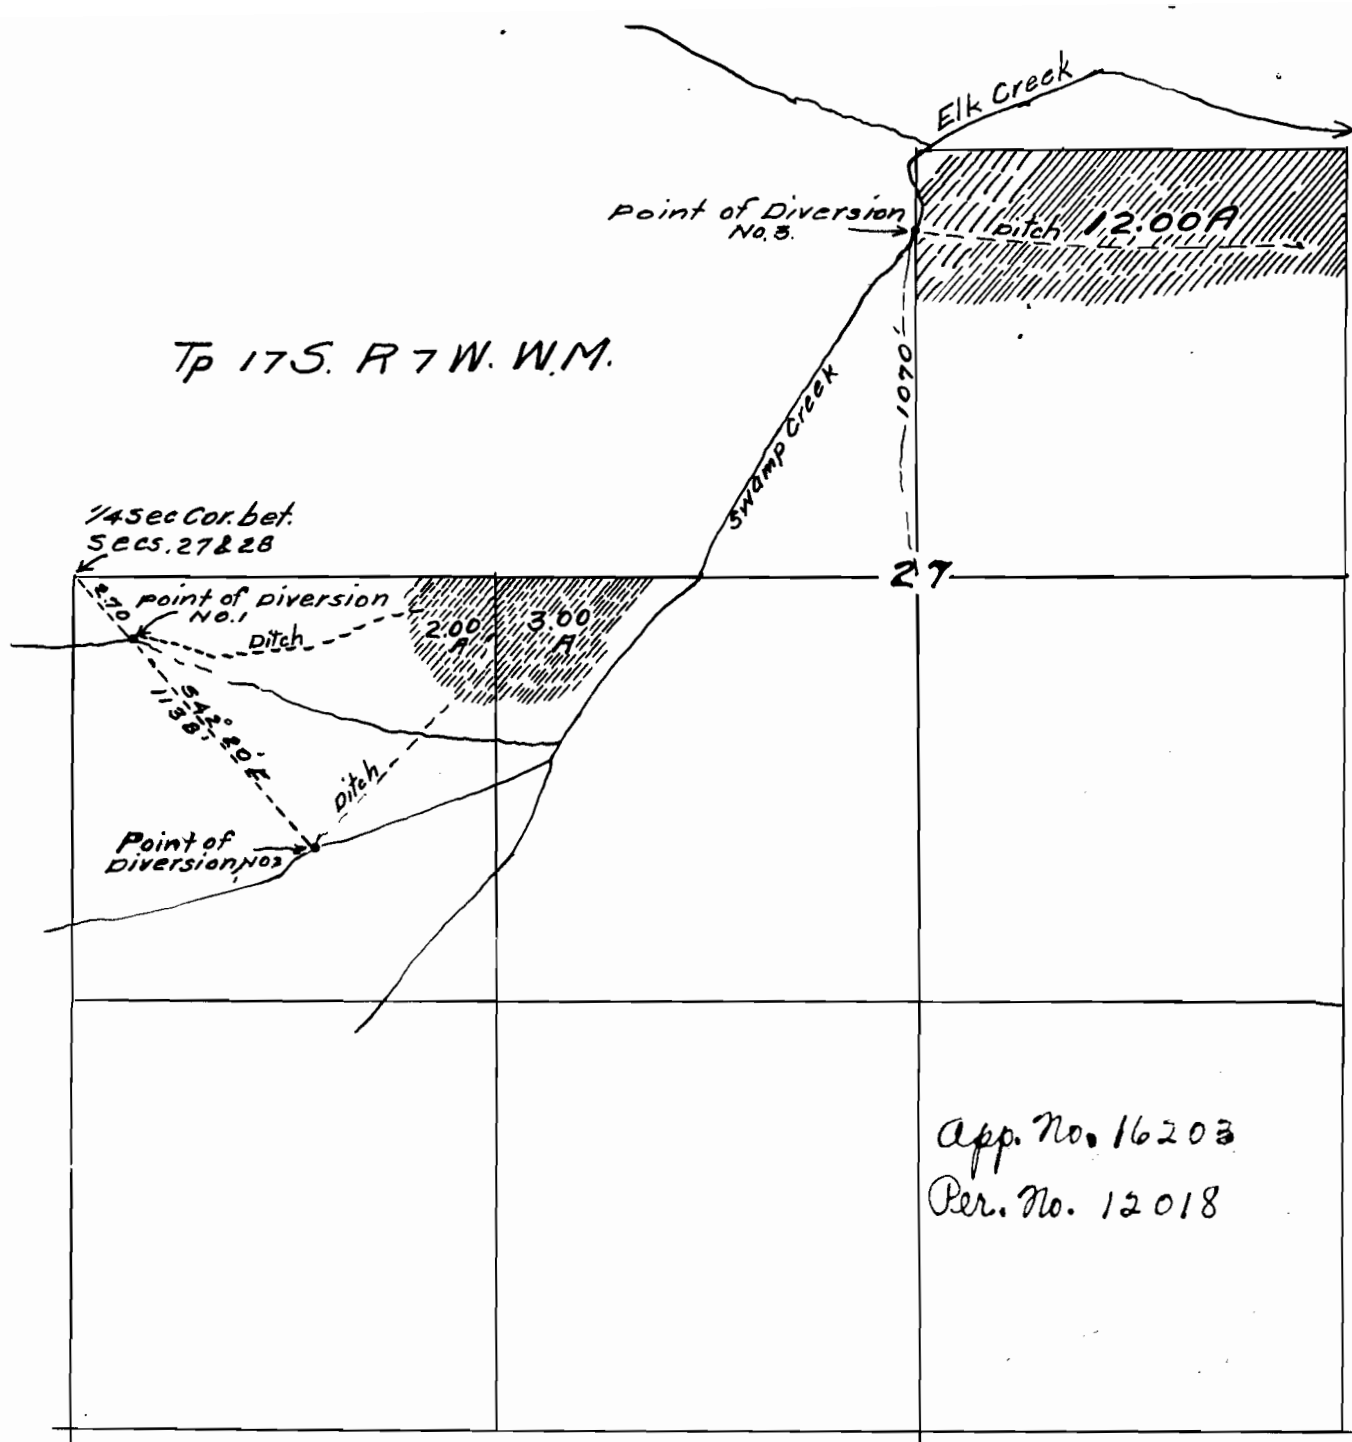

I, G.H. Waggoner do hereby certify that this map was made from notes taken during an actual survey made under my direction Dec 12th 1931 and that it correctly represents the works described in the accompanying application together with the location of streams and other ditches in the immediate vicinity

G.H. Waggoner
 Engineering Certificate, Oregon, No. 954.
 Dated, Dec. 31st 1919.