


... Maud Gibson ...
To Appropriate Water
In Section 10 T17S-R19E
W M
Scale 8" = 1 Mile

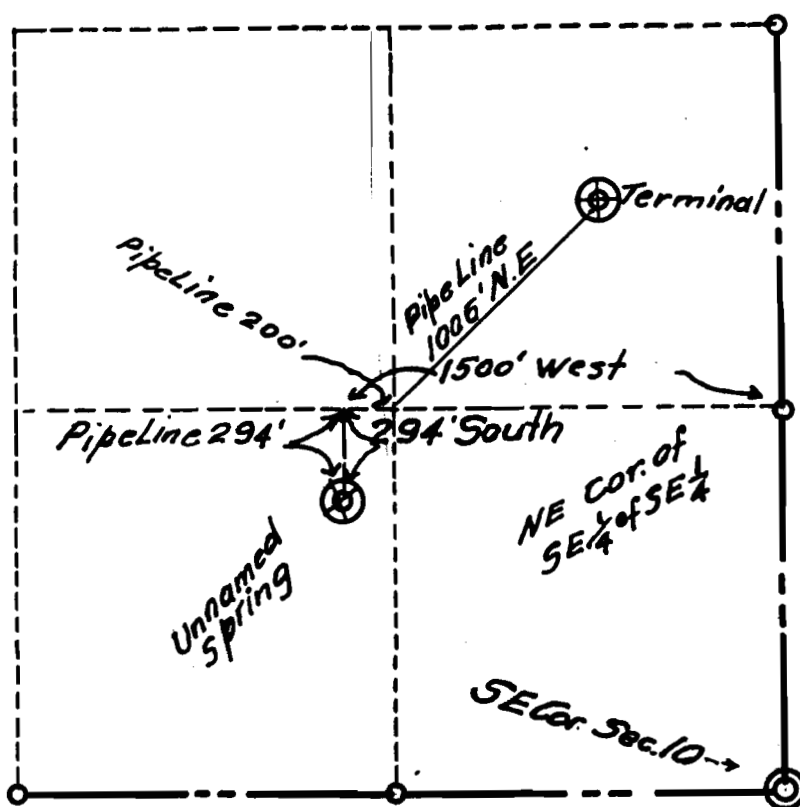

Application No. 16682
Permit No. 12449