


T. 28 S. R. 13 W. W. M.

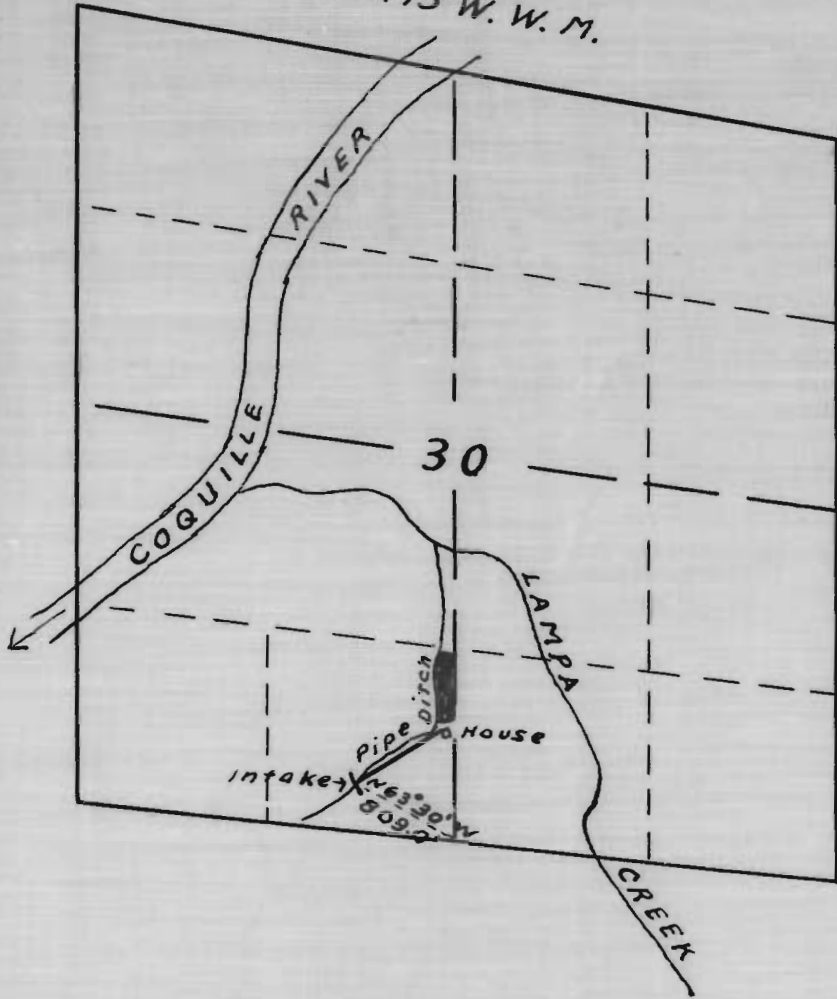

Map accompanying
application of
BONNIE I. WALLEN
to
appropriate water.

RECEIVED
DEC 21 1936
STATE ENGINEER

I, J.N. Gearhart, of Myrtle Point, Oregon, do hereby certify that this map was made from notes taken during an actual survey made by me on Dec. 15, 1936, and that it correctly represents the works described in the accompanying application, together with the location of streams and other ditches in the immediate vicinity.

J. N. Gearhart
No. 183.

Application No. 16718
Permit No. 12504

16718
17-19

