


T.39 S. R.14 W. W.M.

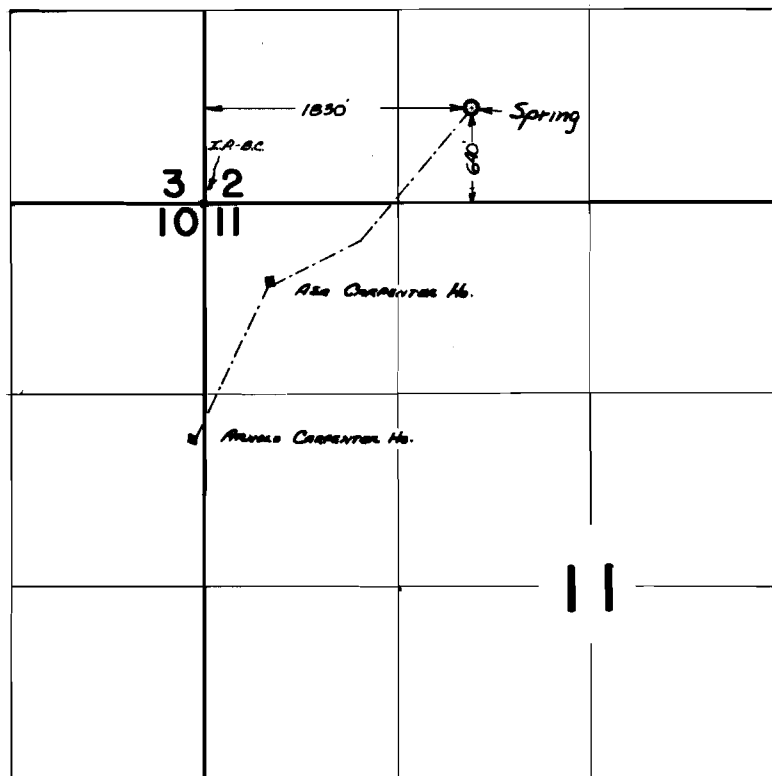

FINAL PROOF SURVEY
UNDER

Application No. 44467 Permit No. 33259
IN NAME OF

ARNOLD CARPENTER

Surveyed 13 SEPT 1969, by L. E. GOULD