


SURVEYORS CERTIFICATE

I. W. E. Anderson of Tillamook, Oregon do hereby certify that this map was made from notes taken during an actual survey made by me on April 1937, and that it correctly represents the works herein shown

Surveyor *W. E. Anderson*

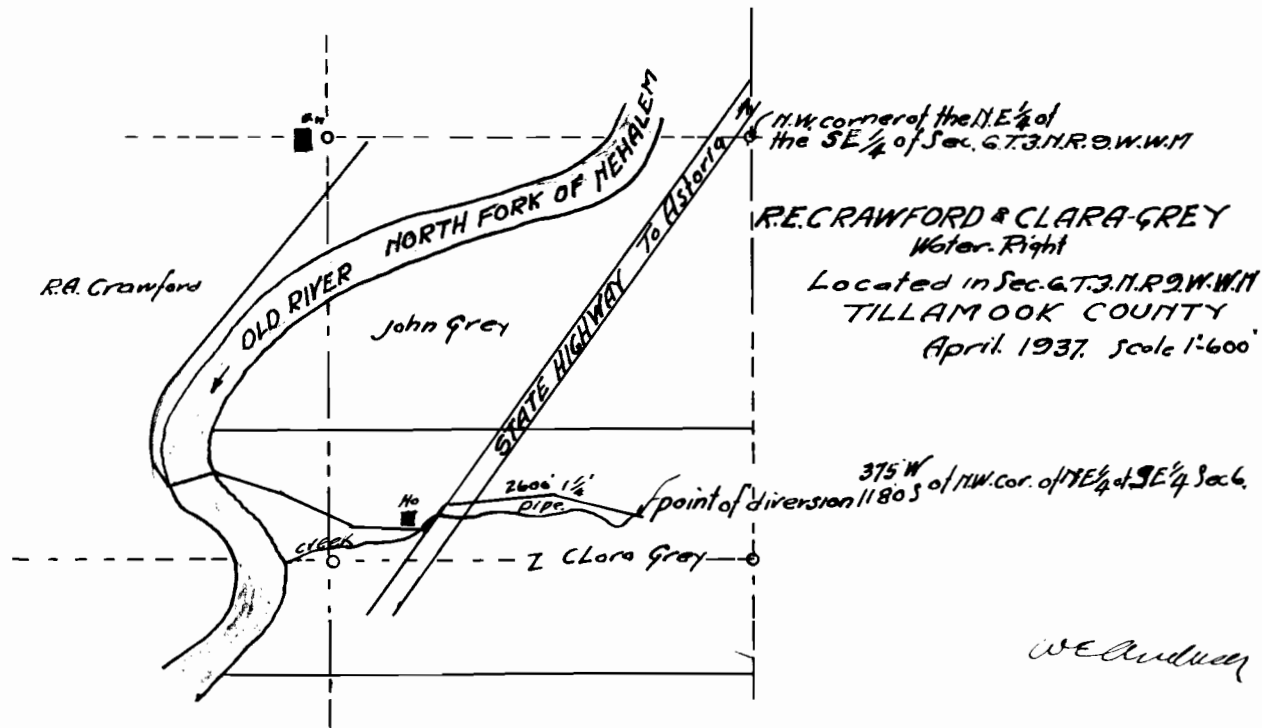

Application No. 16845

Permit No. 12612

1-12-16845-4

W. E. Anderson