


100
80 60
25

PROOF MAP

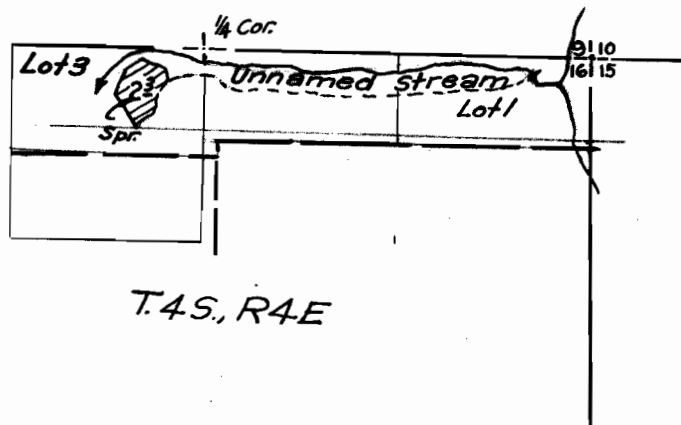

App. 12944 944

Per. 9265265