


SECTION

TOWNSHIP 5 S , RANGE 1 W , W. M.

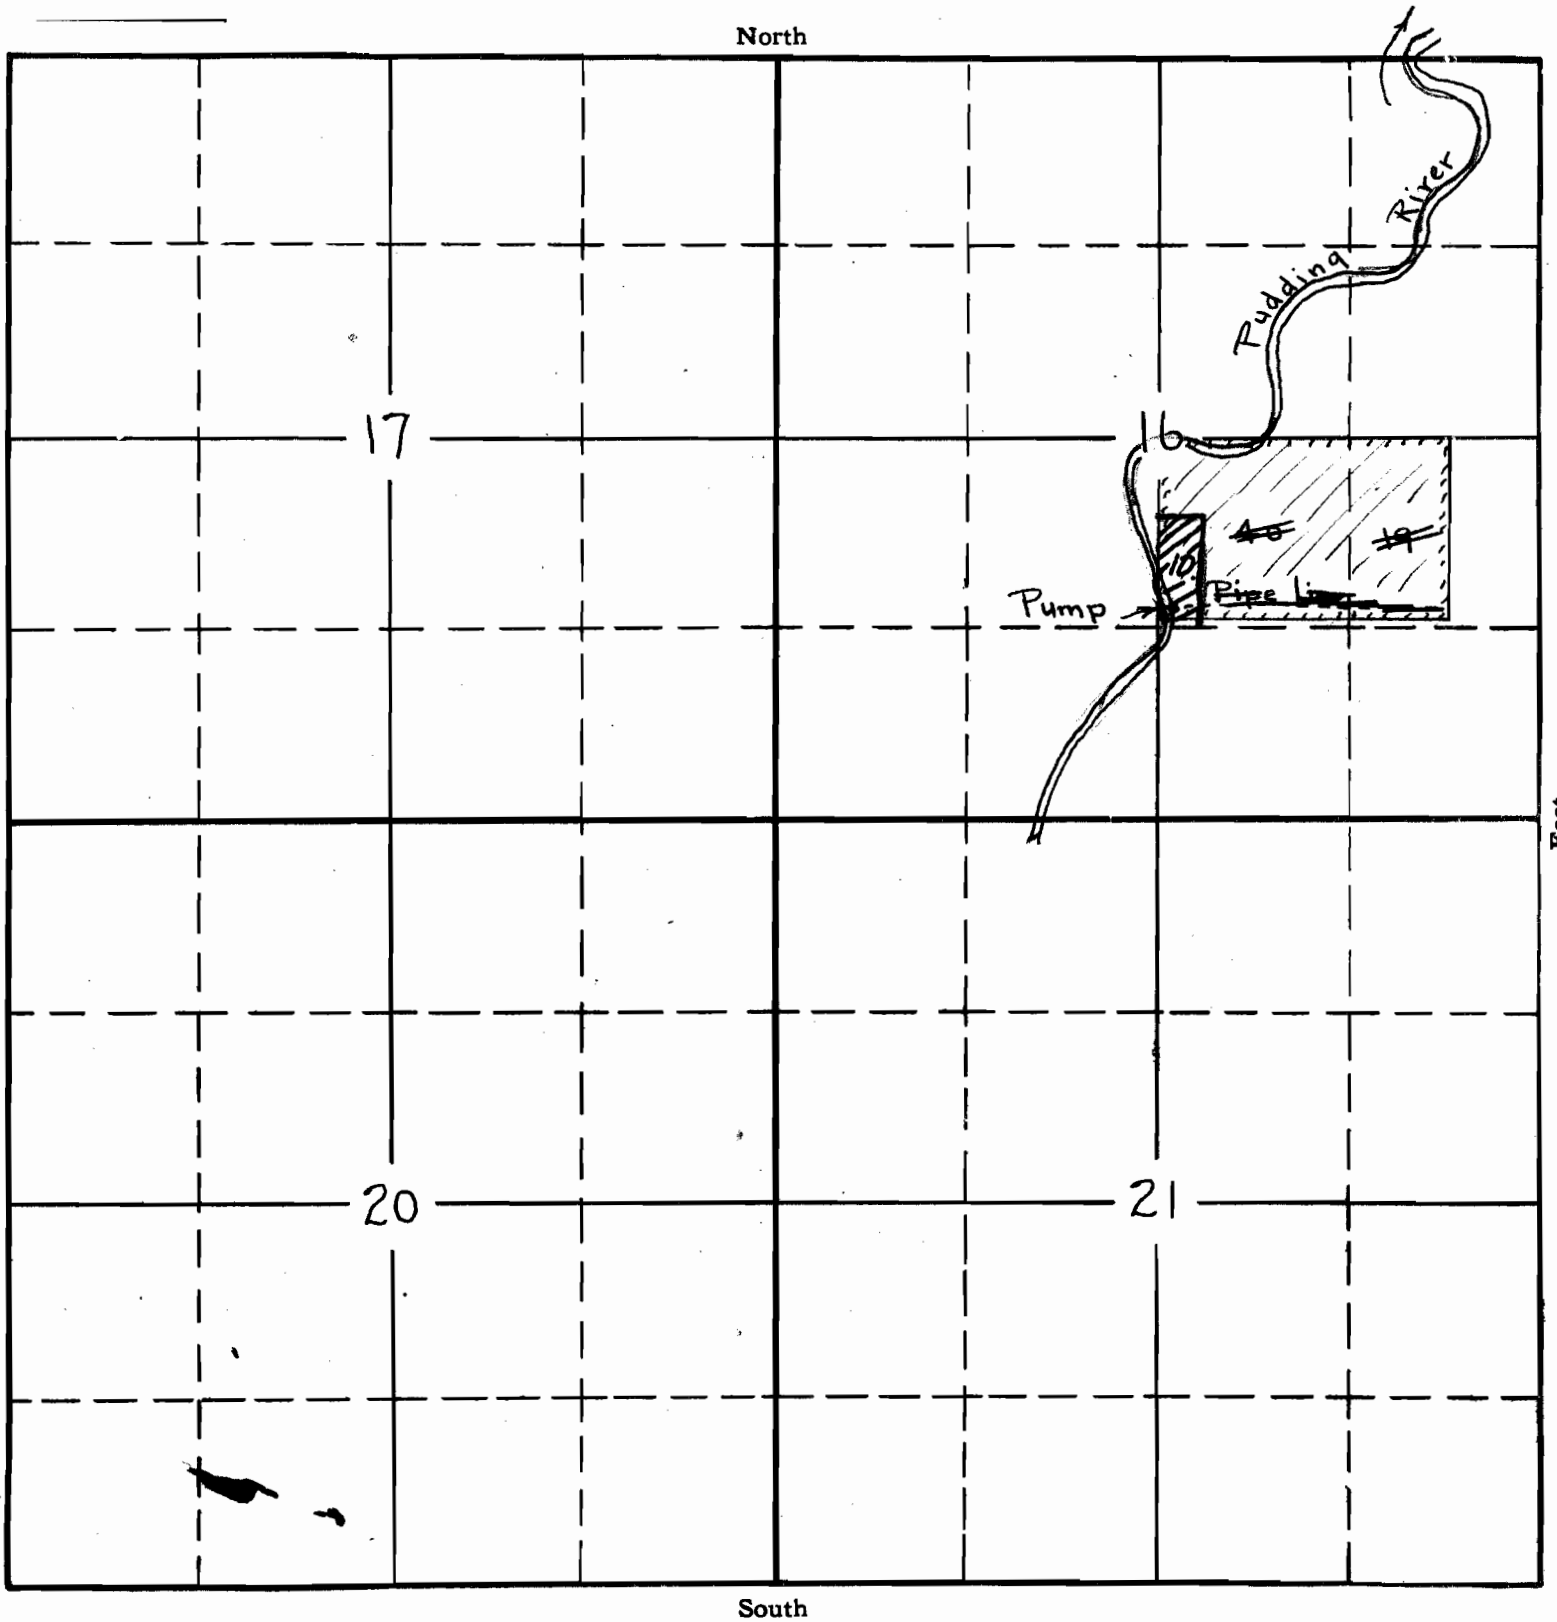


APPLICATION No. 13758  
PERMIT No. 9891

SECTION

TOWNSHIP \_\_\_\_\_, RANGE \_\_\_\_\_, W. M.

North

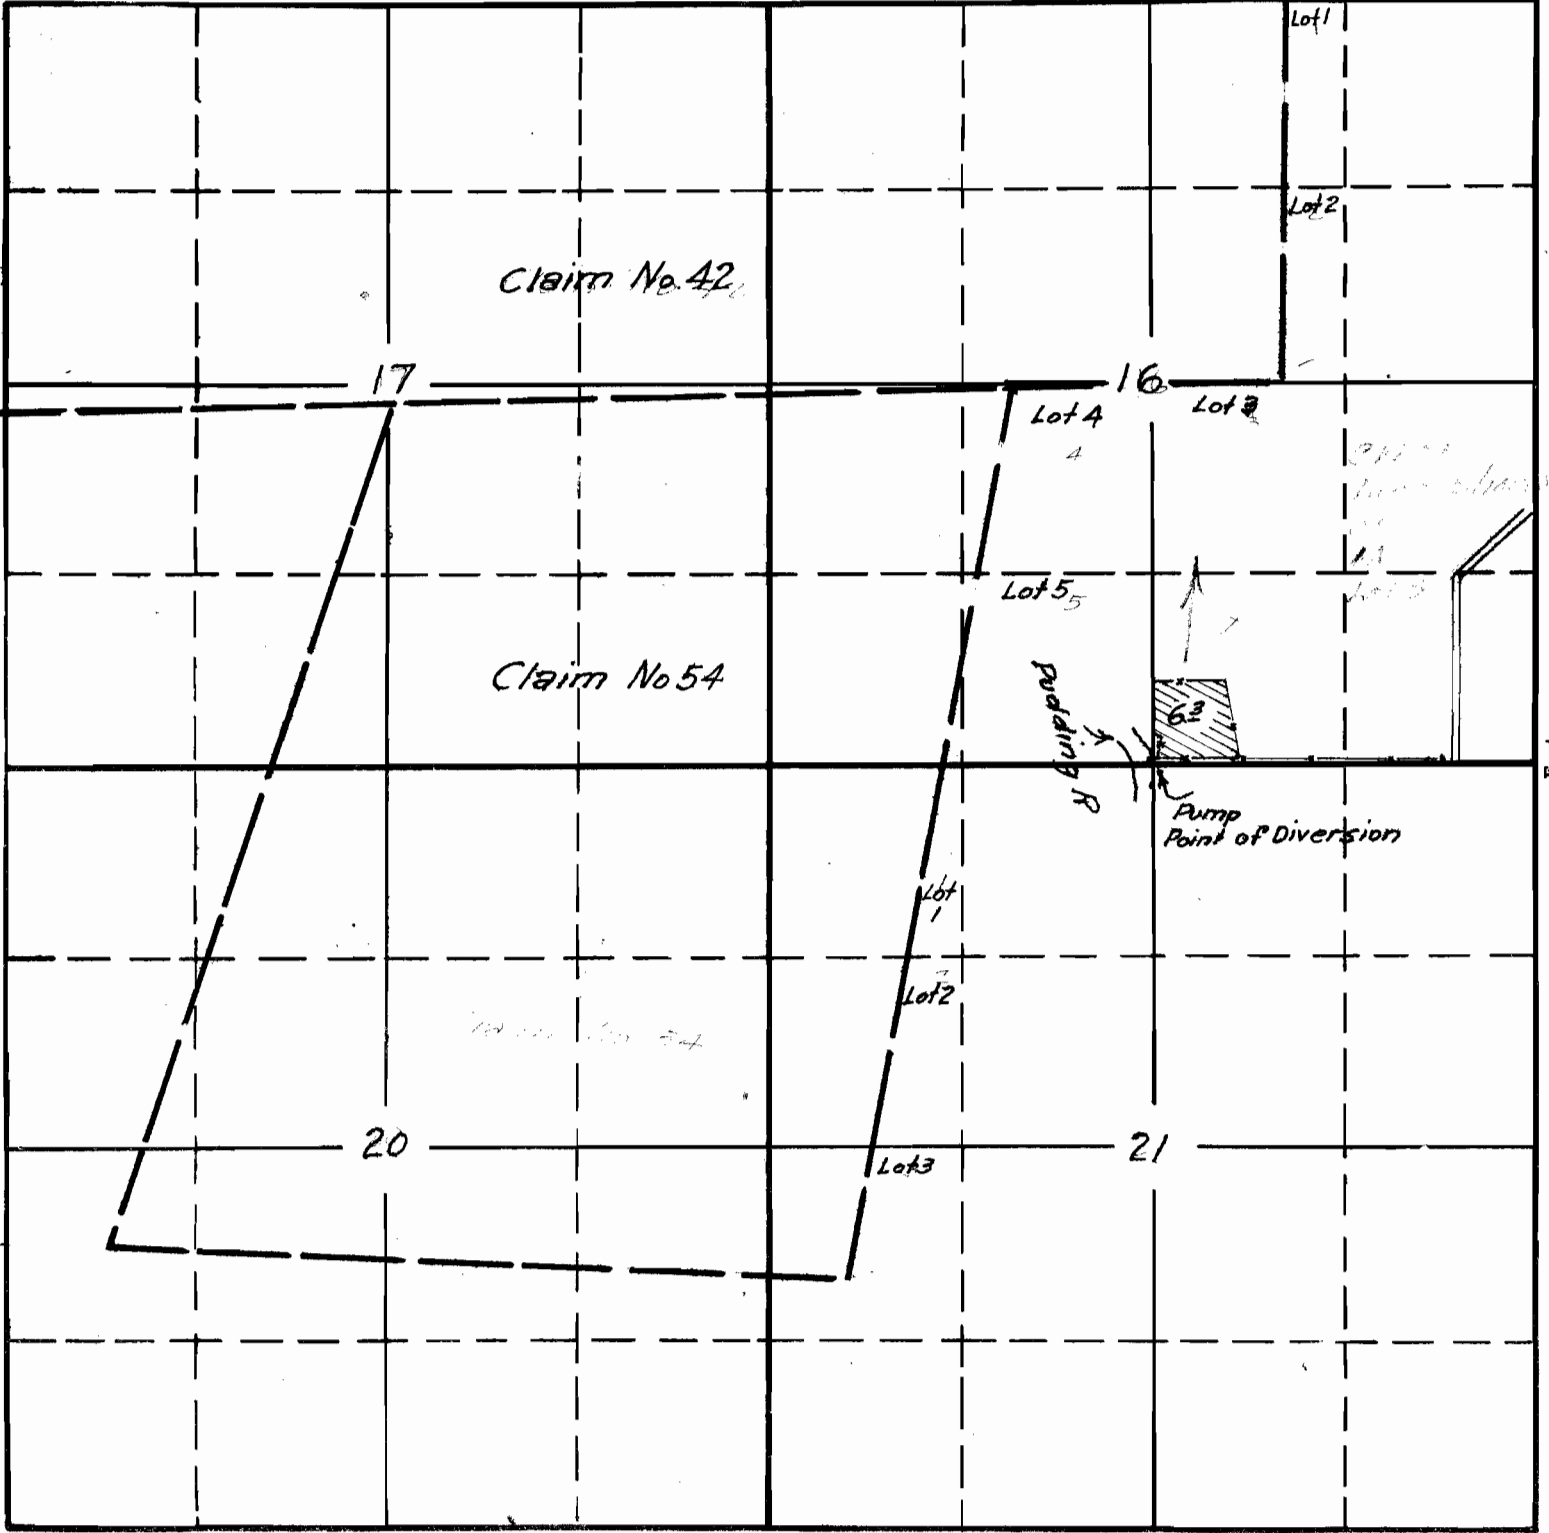

South

APPLICATION No. 13758

PERMIT No. 9891

*filed with proof*