

SECTION

\_\_\_\_\_


\_\_\_\_\_

\_\_\_\_\_

\_\_\_\_\_

TOWNSHIP 1N, RANGE 43E, W. M.

North

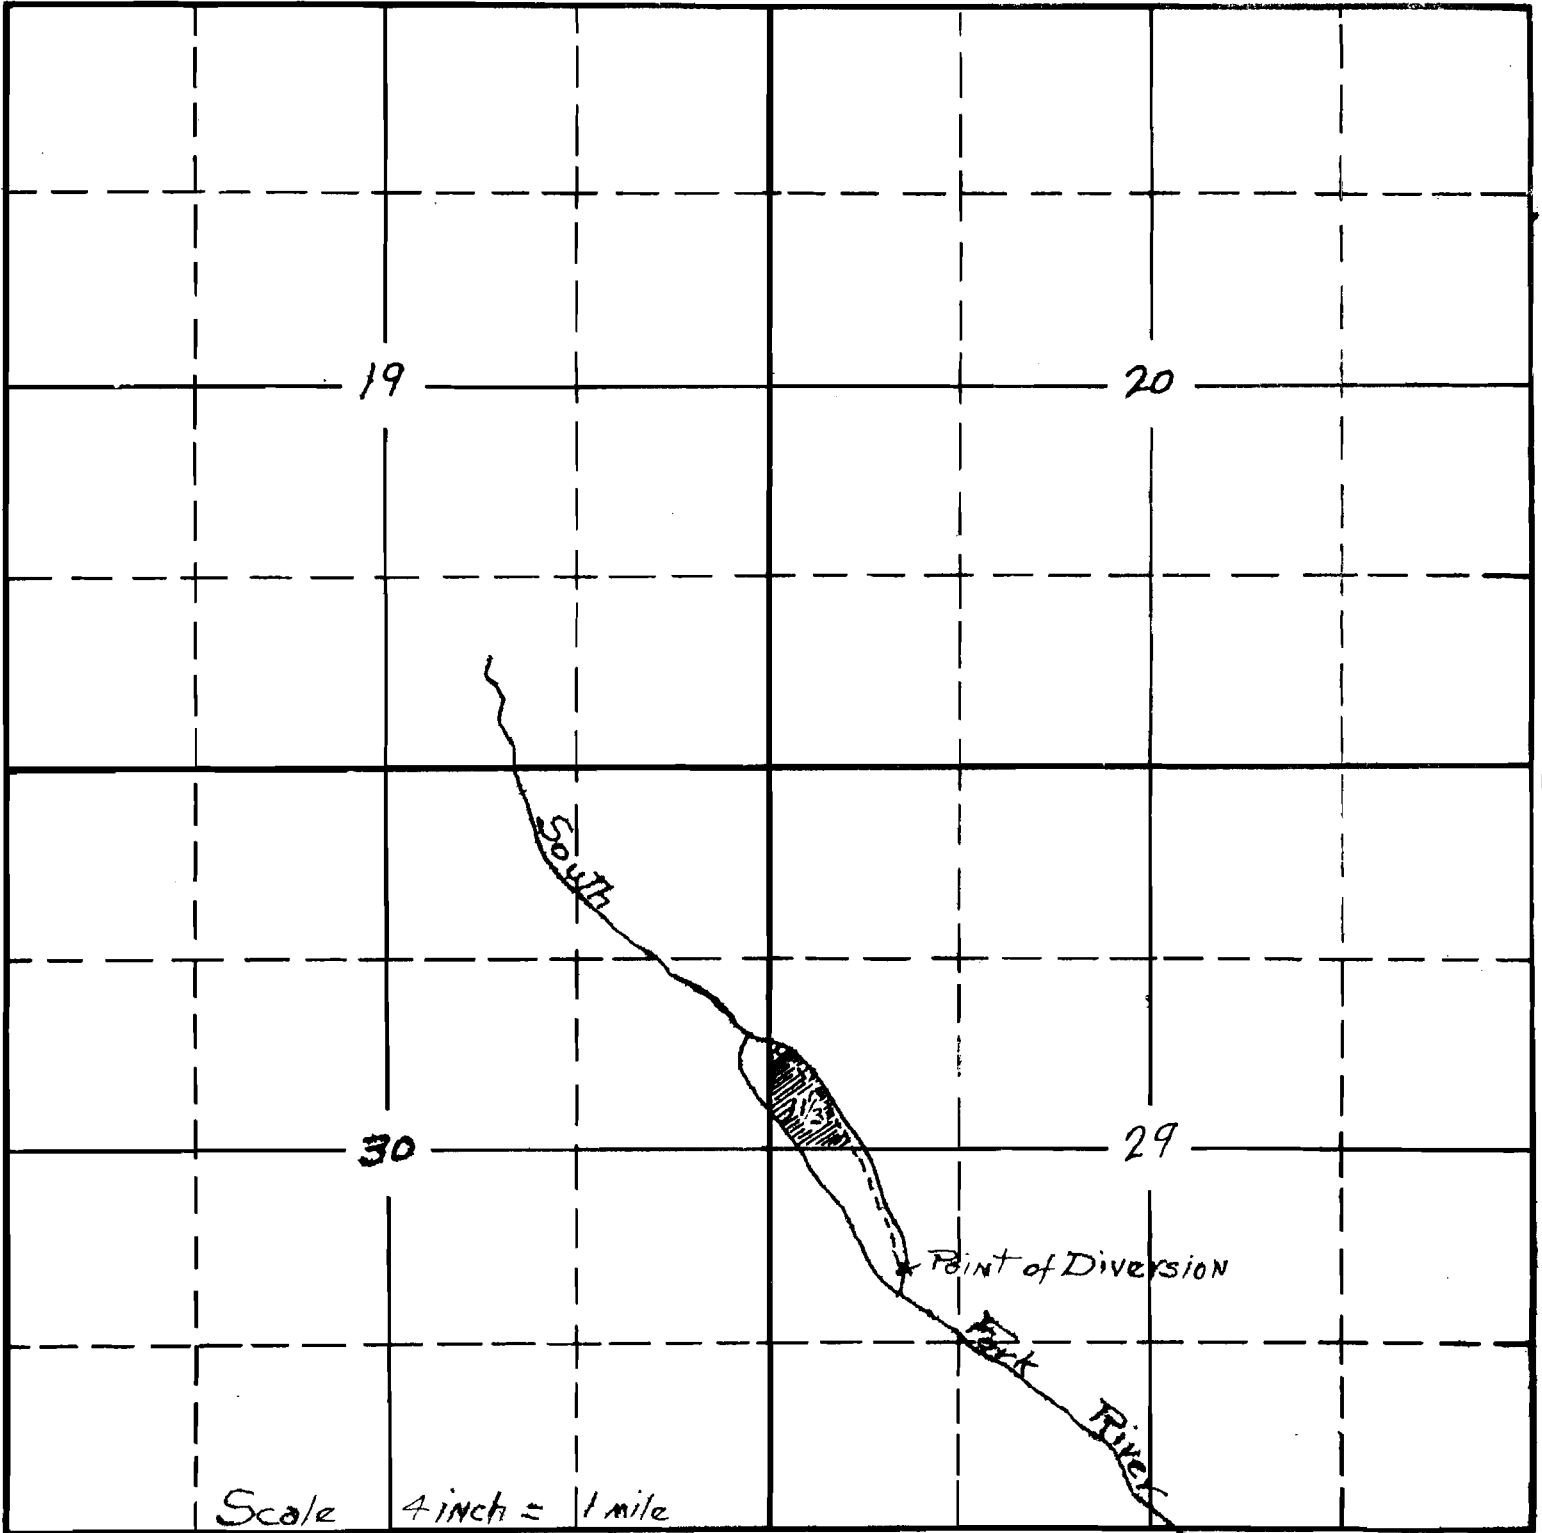

Scale 4 inch = 1 mile

South

16974 MS

RECEIVED

JUL 12 1937

STATE ENGINEER  
SALEM, OREGON

APPLICATION No. 16974

PERMIT No. 12927