


TOWNSHIP 35 S, RANGE 6 W., W. M.

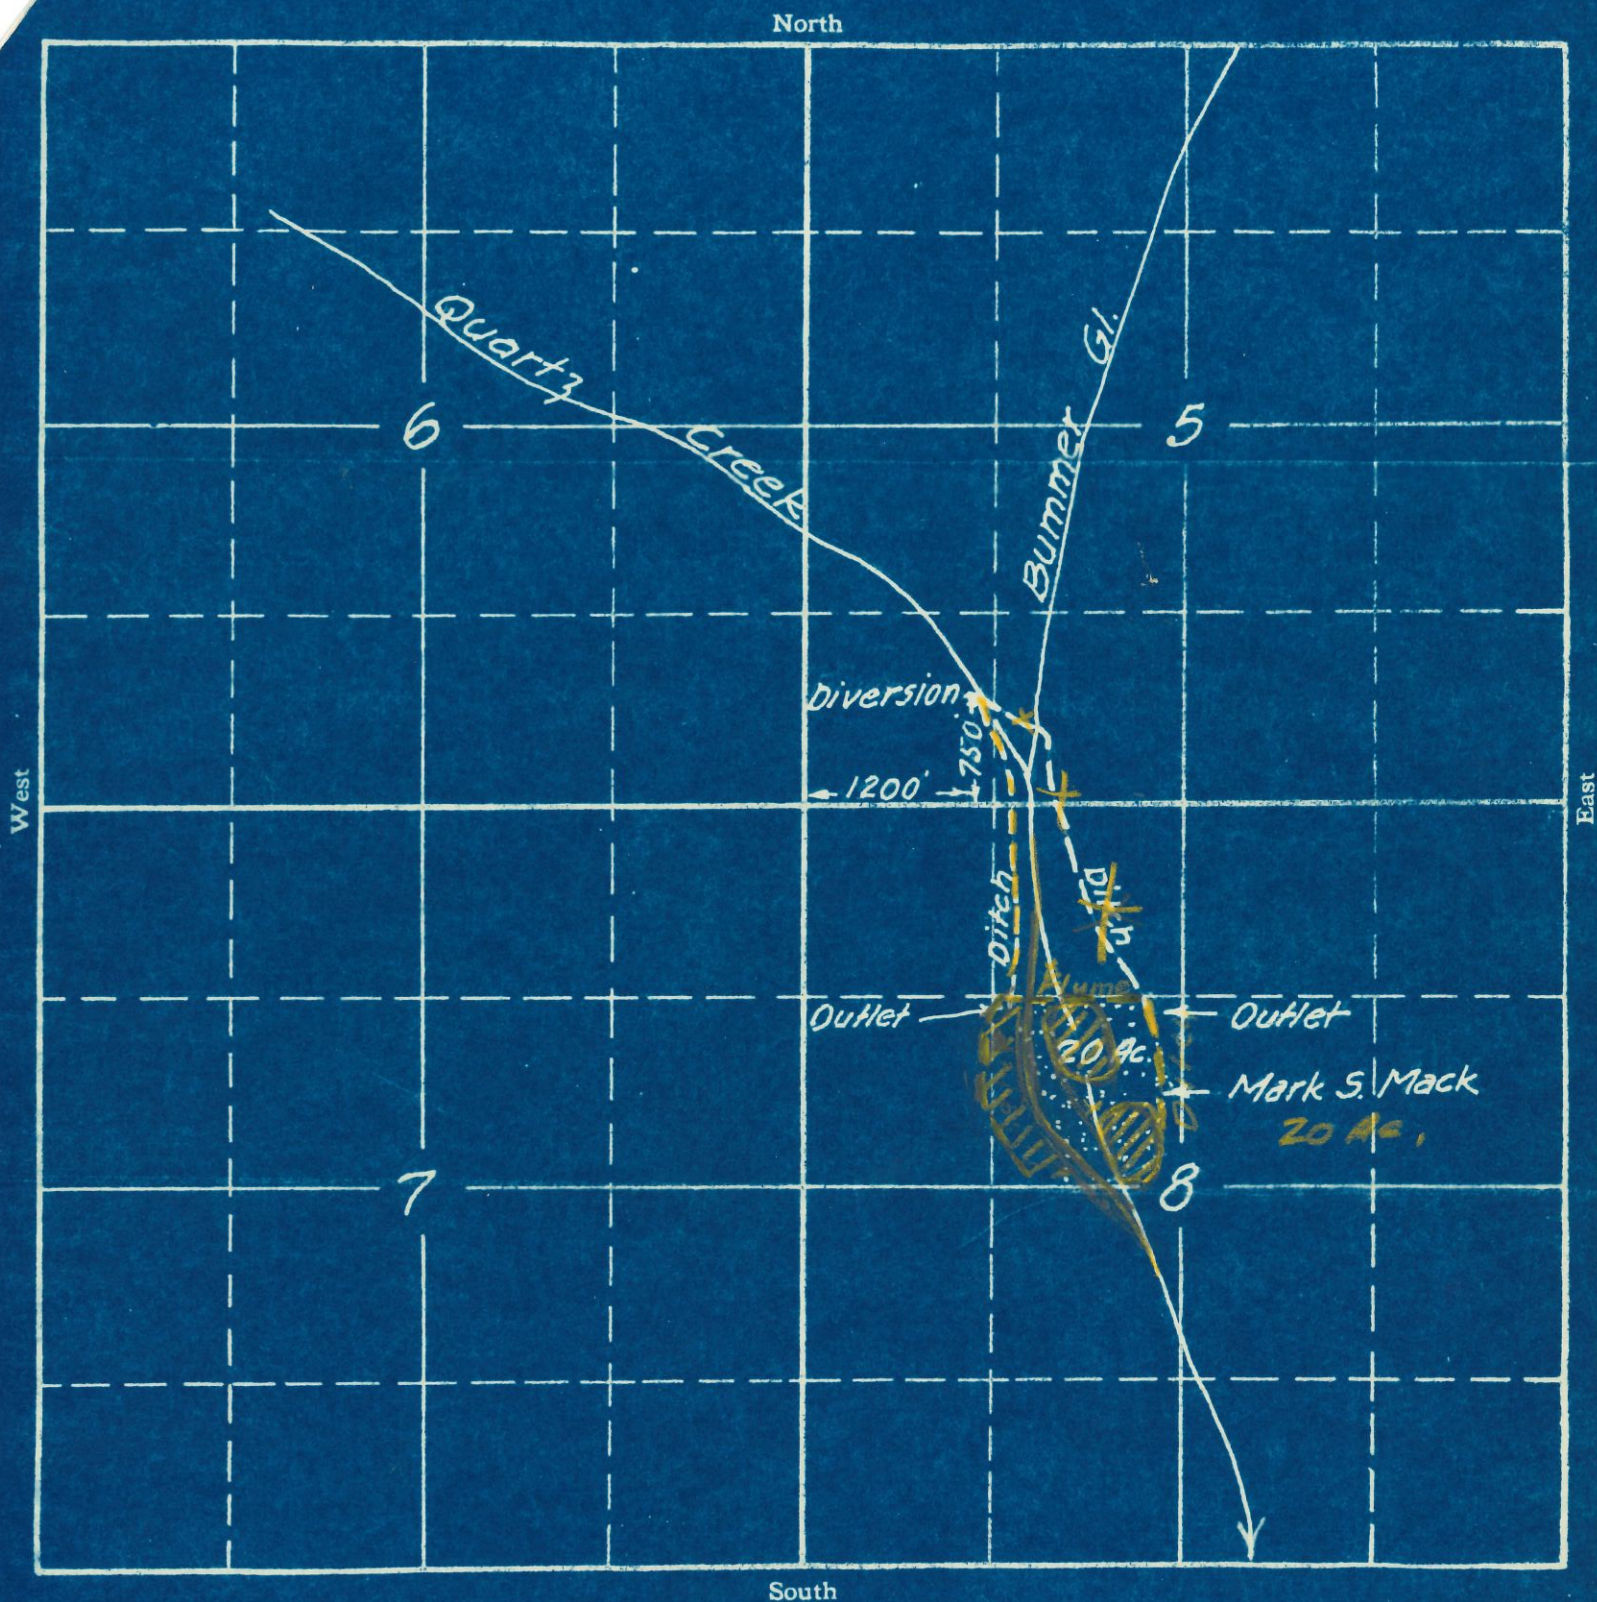

APPLICATION No. 15833

PERMIT No. 11685