


T.2S.R.3&4W. W.M.

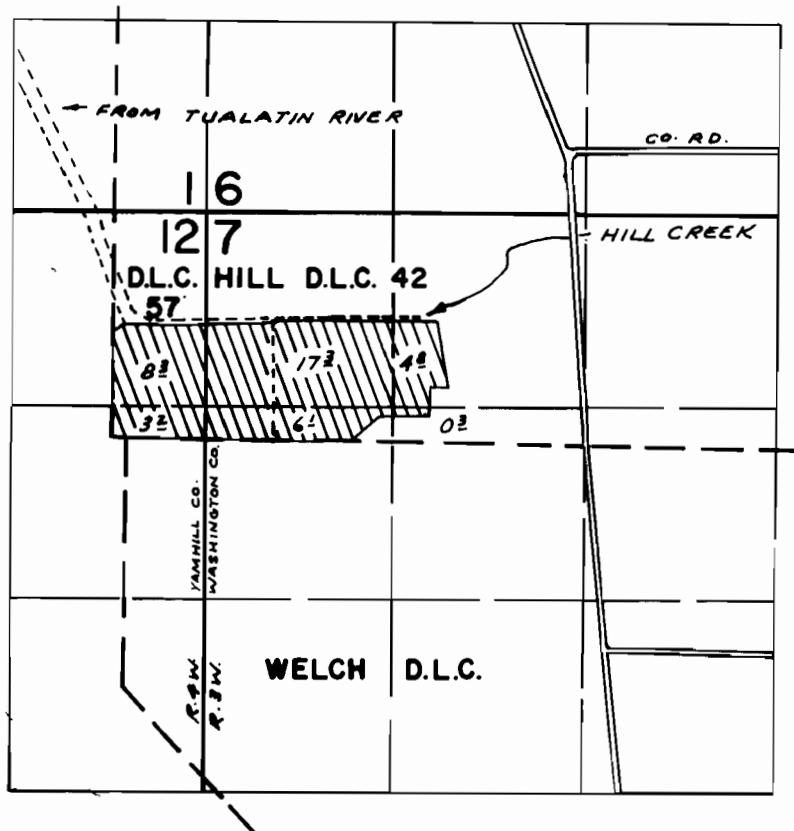

DIV. PTS. LOC: HILL CR. - NW $\frac{1}{4}$ NW $\frac{1}{4}$, NE $\frac{1}{4}$ NW $\frac{1}{4}$ SEC. 7, T. 2S. R. 3W.
 NE $\frac{1}{4}$ NE $\frac{1}{4}$ SEC. 12, T. 2S. R. 4W.; TUALATIN RIVER - NW $\frac{1}{4}$ SW $\frac{1}{4}$
 SEC. 36 T. 1S. R. 4W.

FINAL PROOF SURVEY UNDER

Application No. 16568 Permit No. 12373
 IN NAME OF

RUSSELL KOPPLIN

Surveyed OCT. 6, 1937, by CHESTER A. CUMMINGS
 REVISED MARCH 23, 1978

NOTE: THIS MAP SHOWS ONLY THAT PORTION UNDER
 PERMIT 12373 OWNED BY RUSSELL KOPPLIN
 AT TIME CERT. 11934 WAS ISSUED

R.G.M.
 DFQ-2LL-26