

SECTION

27


Cabin 69

12529

11937

TOWNSHIP 40 S., RANGE 3 E., W. M.

North

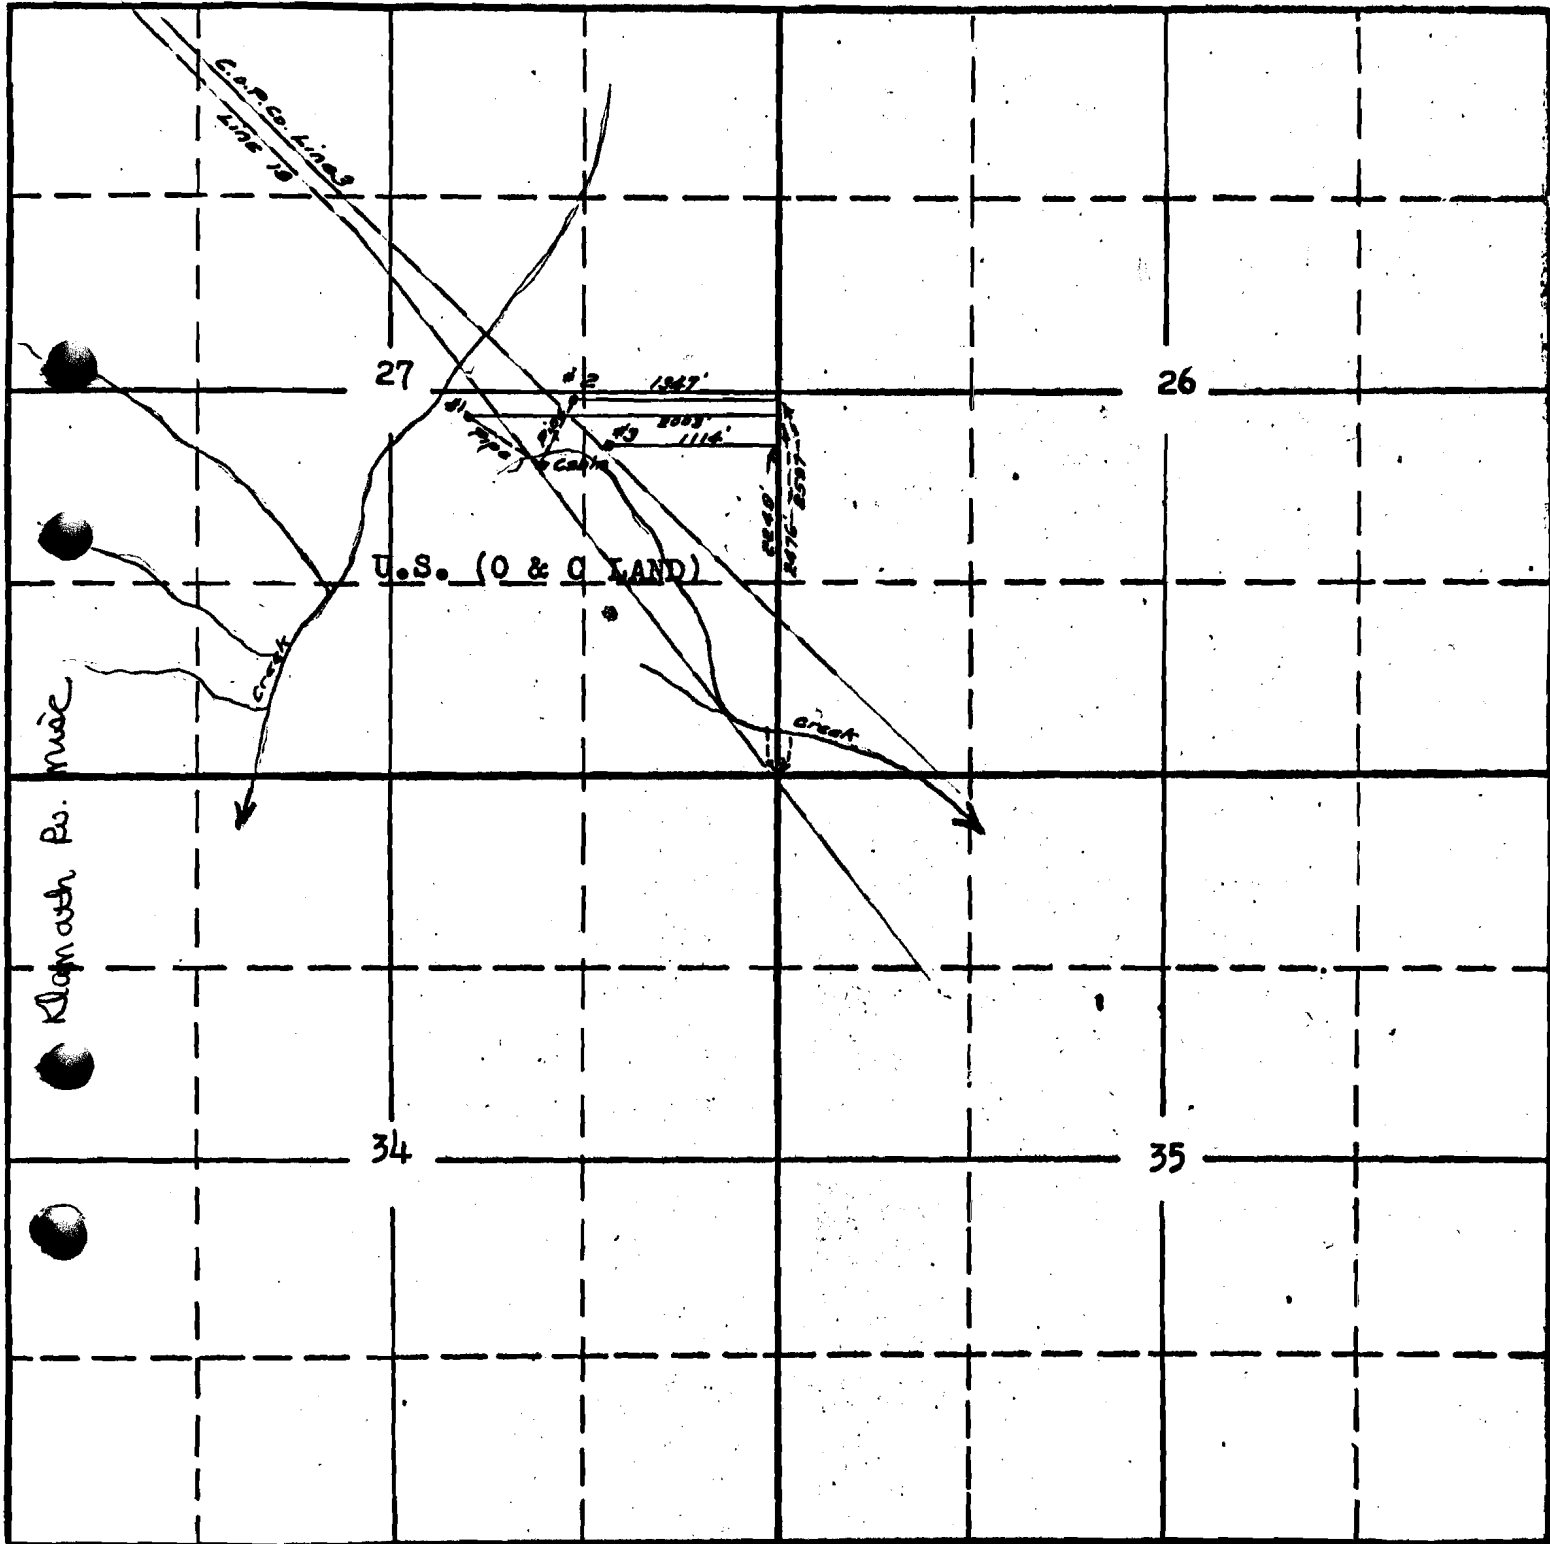

South

RECORDED  
JAN 15 1937

14- 16749-OK  
APPLICATION No. 16749  
PERMIT No. 12529

STATE ENGINEER