


APP 16750

11939 12530

Cabin 90

TOWNSHIP 40 S., RANGE 3 E., W. M.

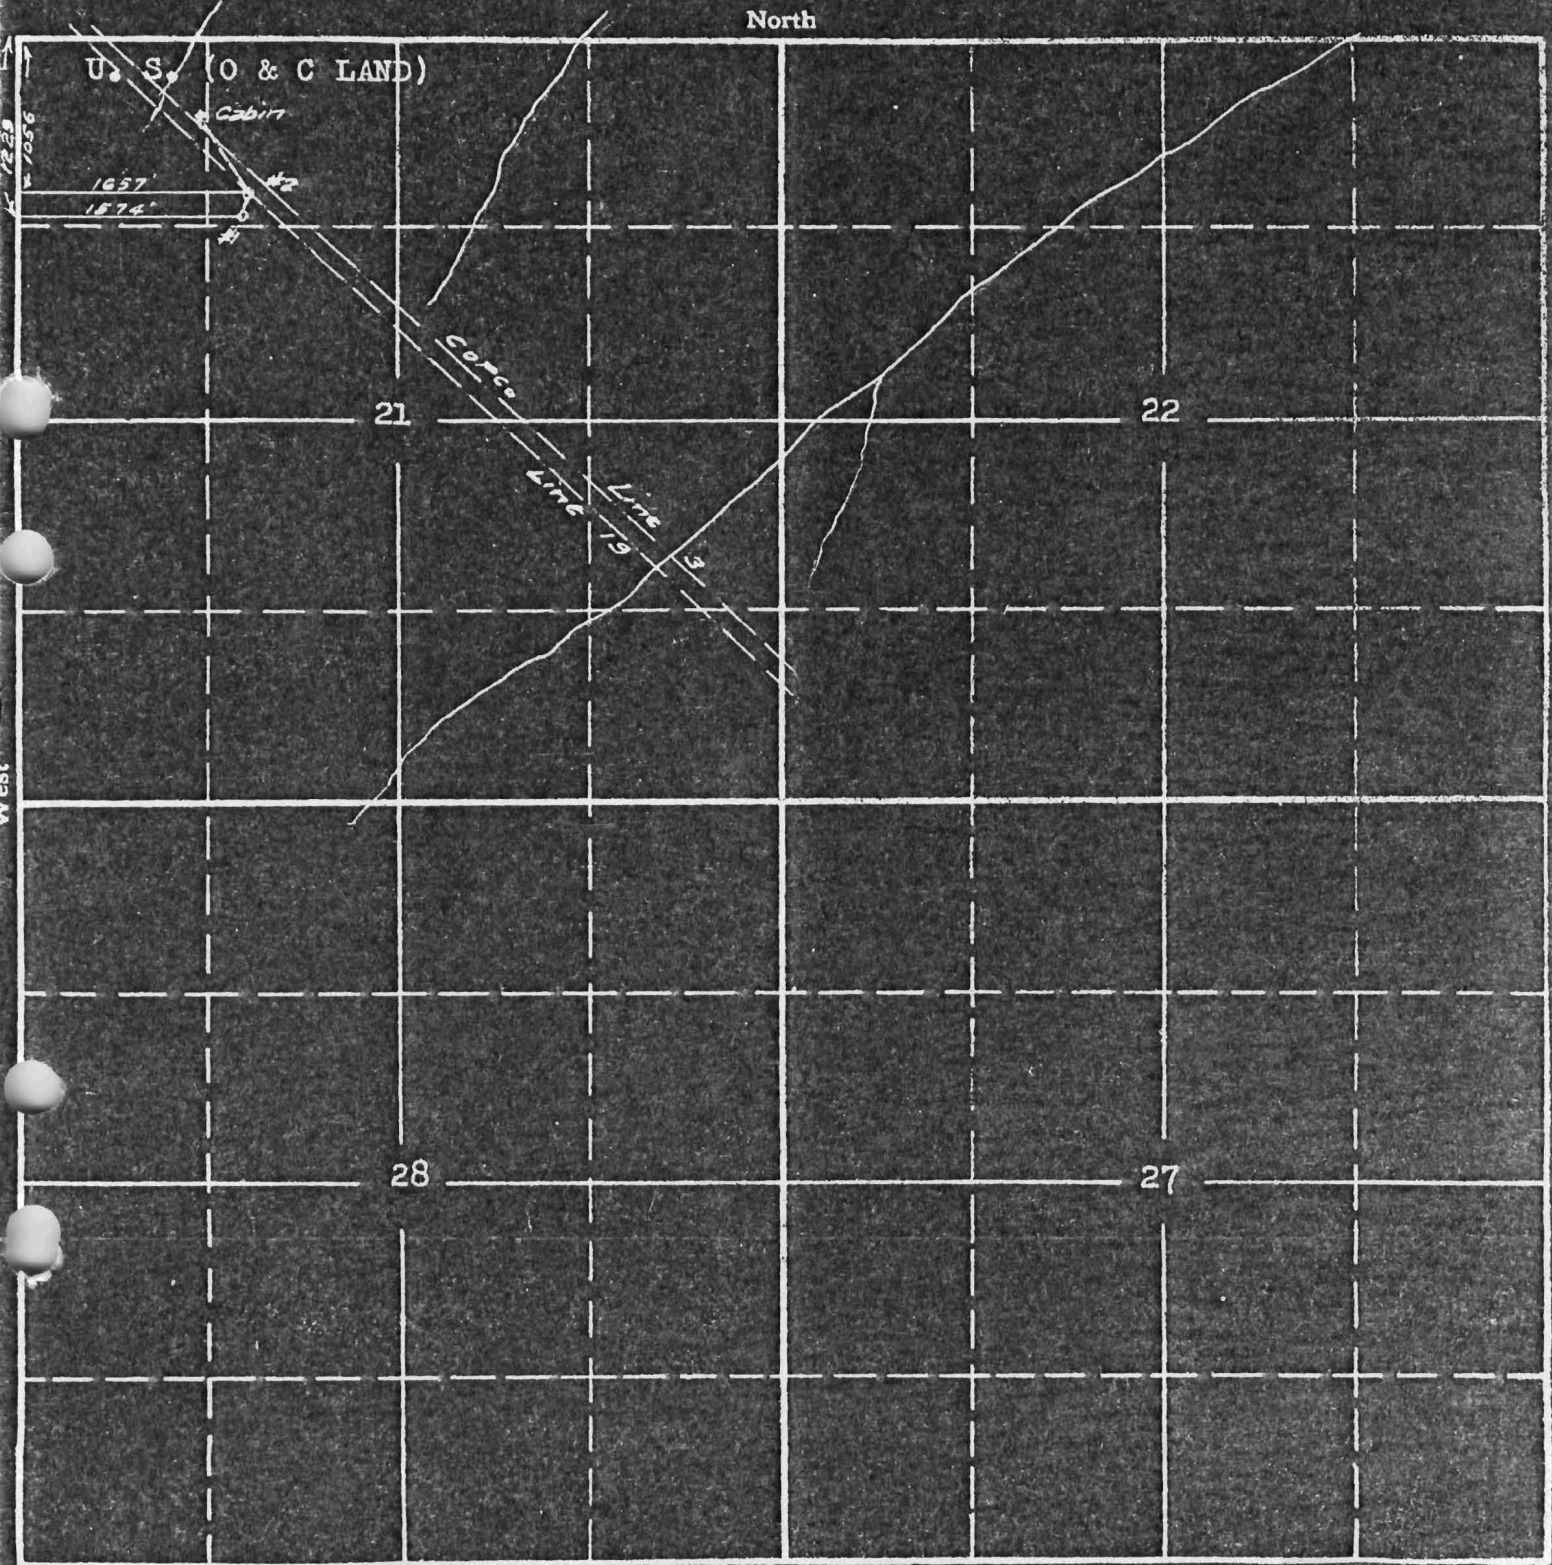

South

14- 16750-01
 APPLICATION No. 16750
 PERMIT No. 12530