


PROOF MAP

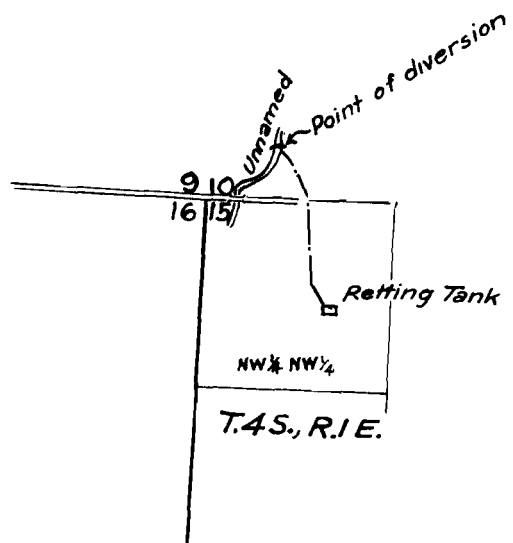

App. 16761
Per. 12538