
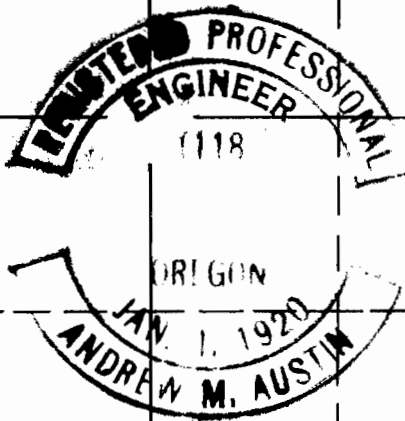


SECTION

TOWNSHIP 3, S , RANGE 10. , W. M.

North

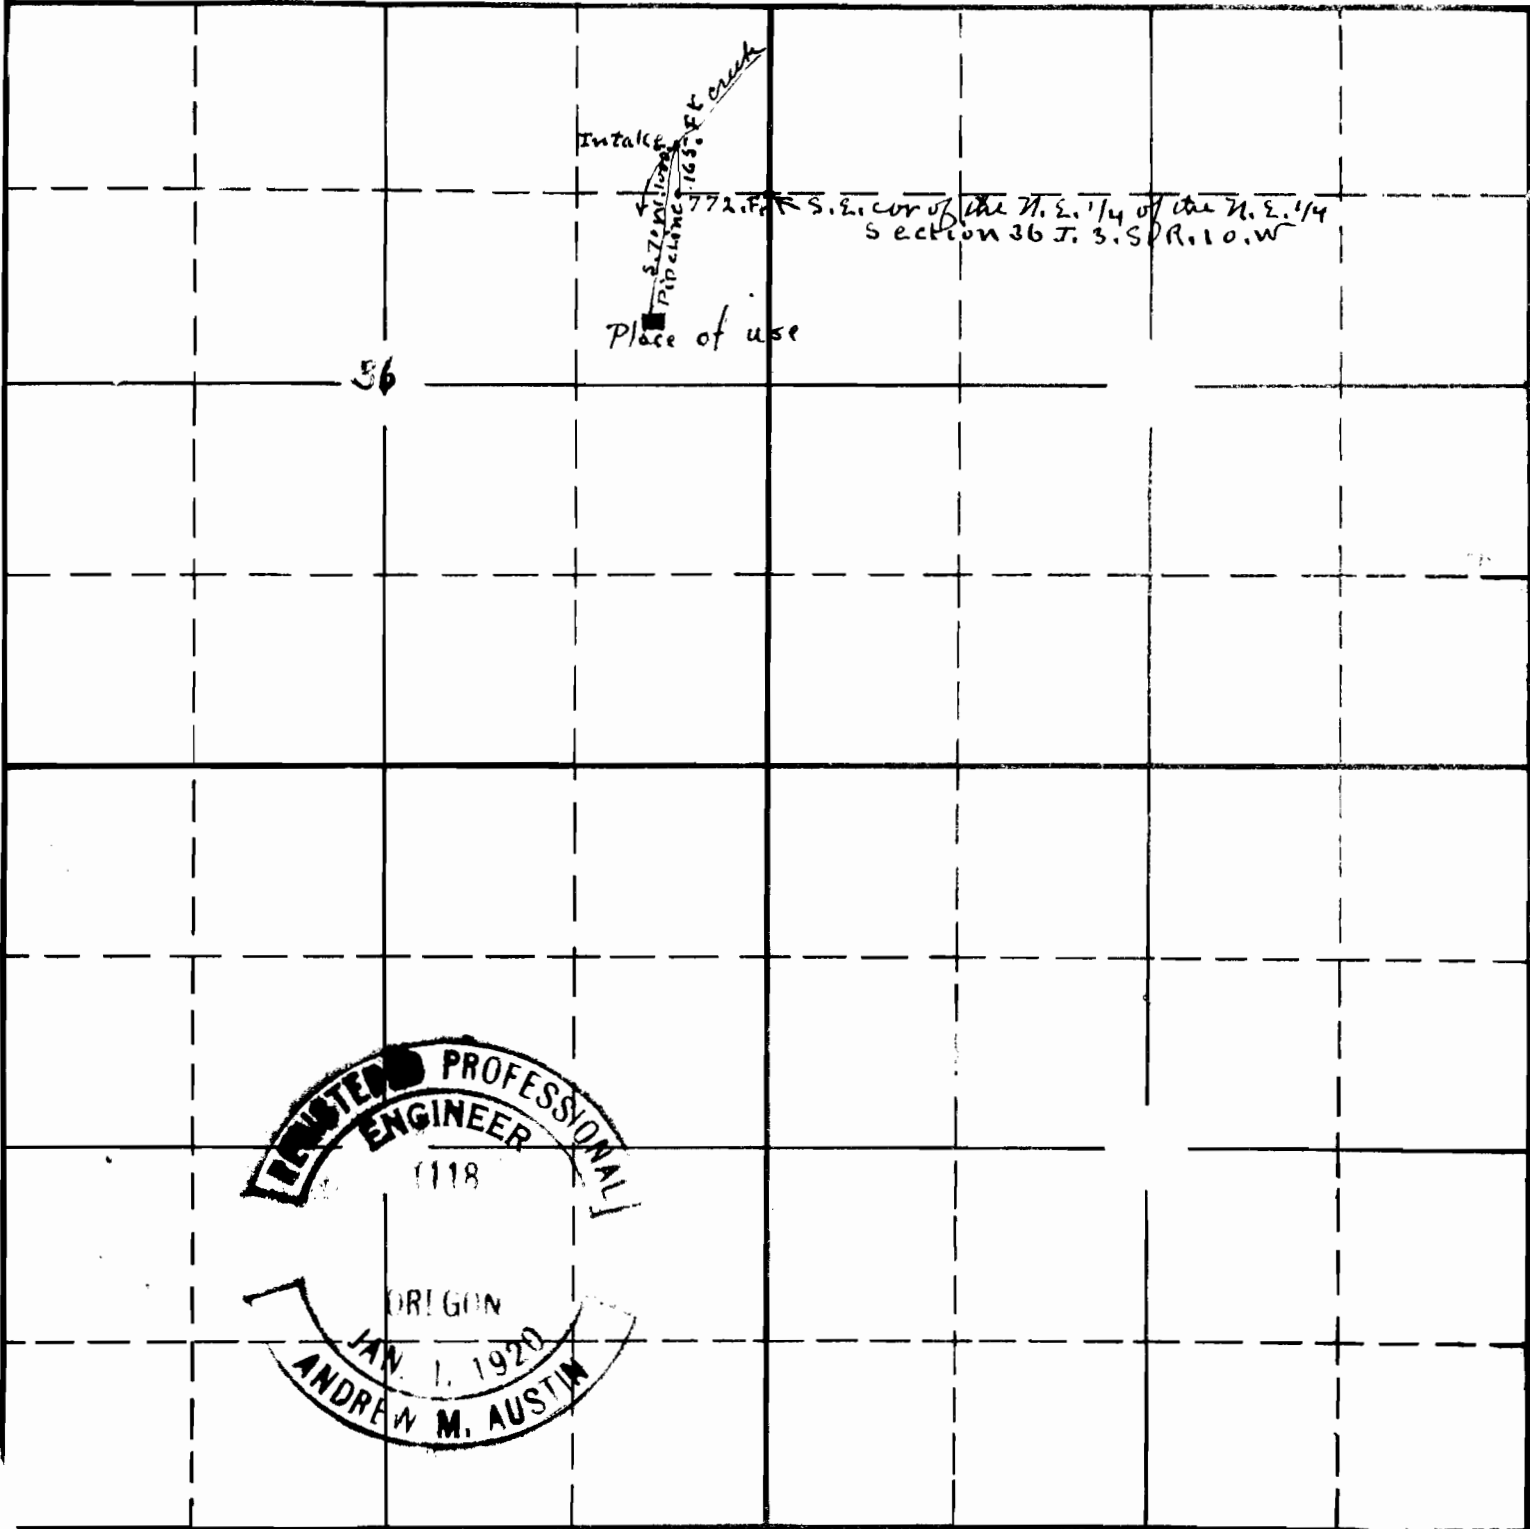

Made by A.M. Austin E.E., South

1-164-16875-4  
 APPLICATION No. 16875  
 PERMIT No. 12632