


Sec. 11  
12  
13  
14  
Tp. 15 S  
R. 14 E

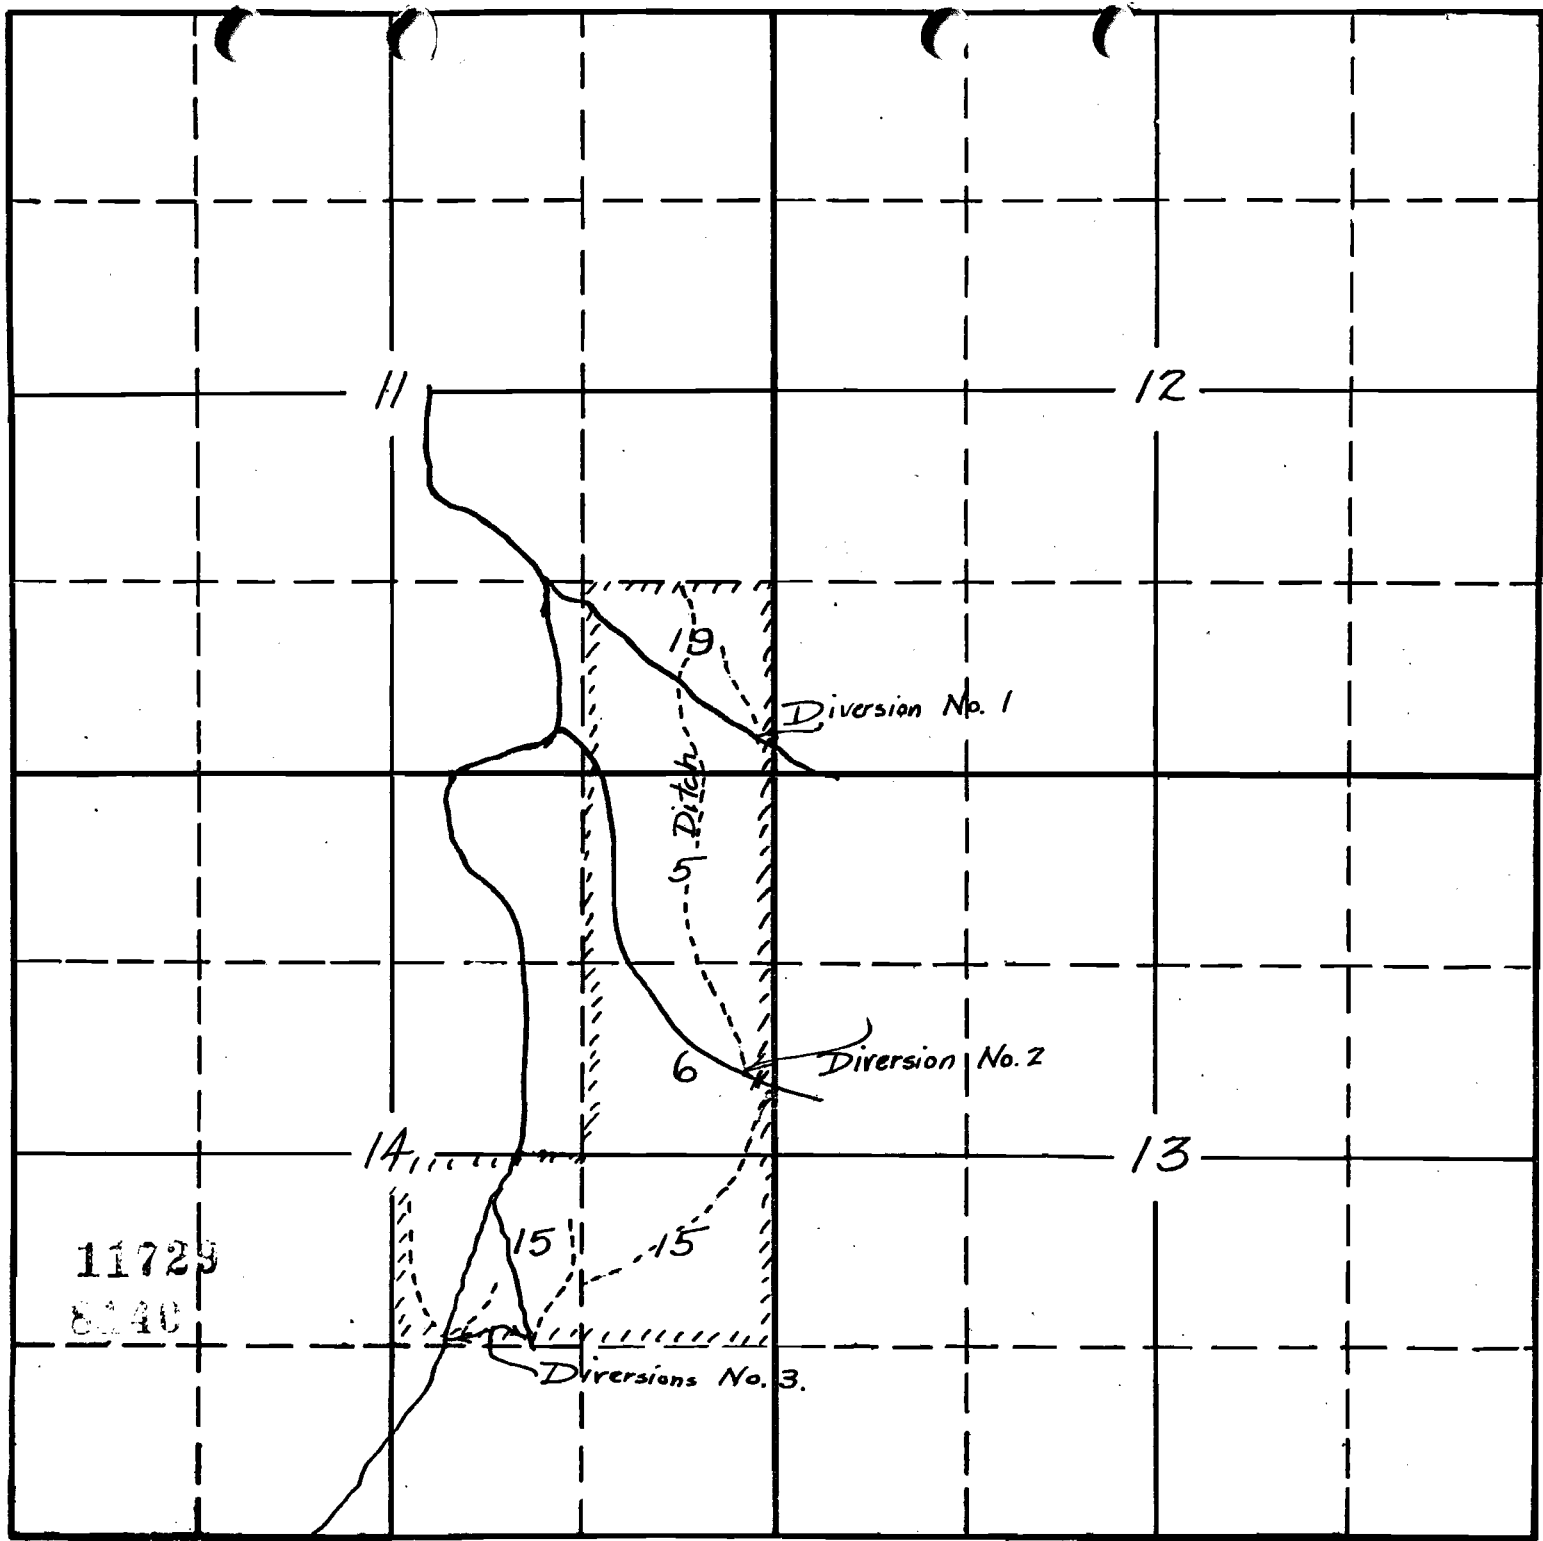

Application No.  
Permit No.

11729  
8240

81401  
7#  
2/1/951

Diversions No. 3.

Diversion No. 1

Diversion No. 2

5 ft. Ditch

RECEIVED

DEC 17 1979


WATER RESOURCES DEPT  
SALEM, OREGON

Township 15 S

Range 14 E

W.M. Crook

Permit # 8140

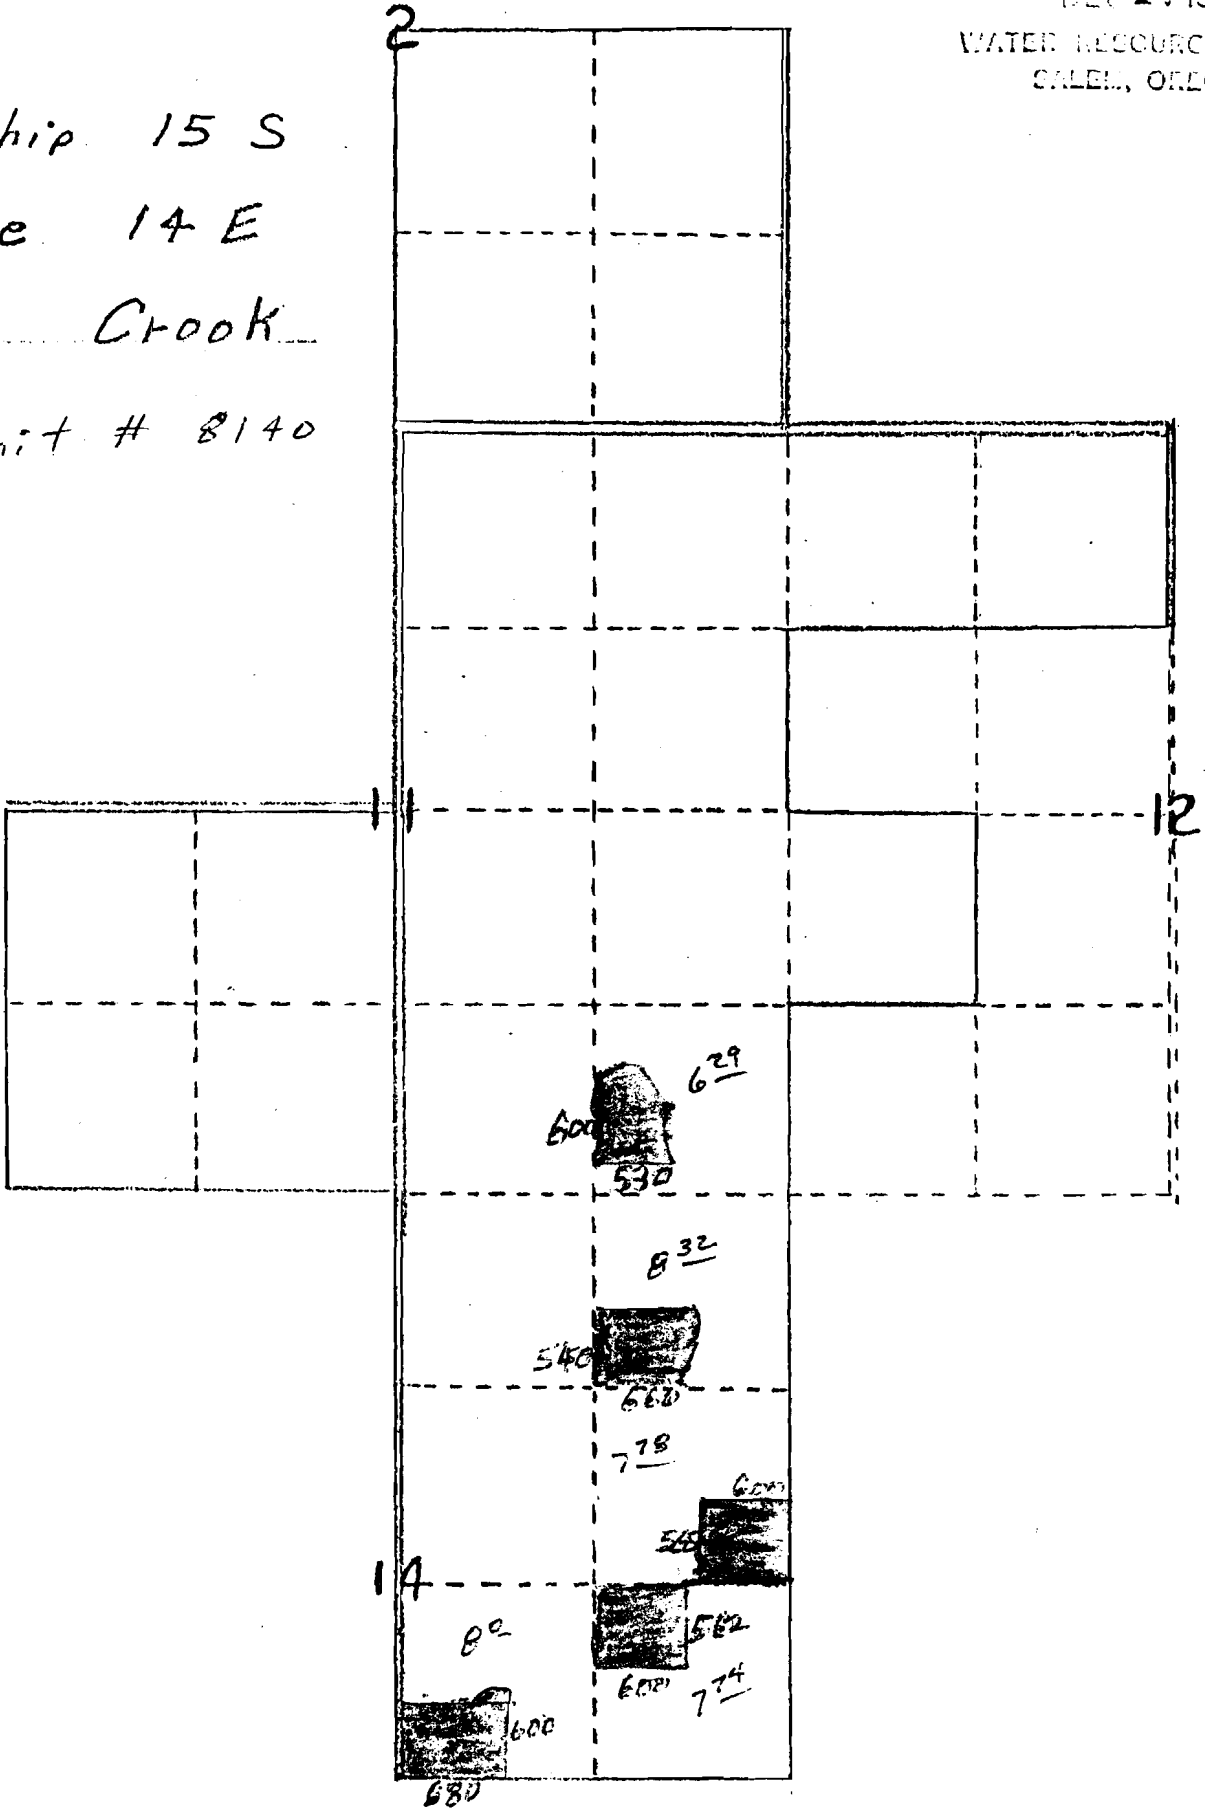

# 2

8140