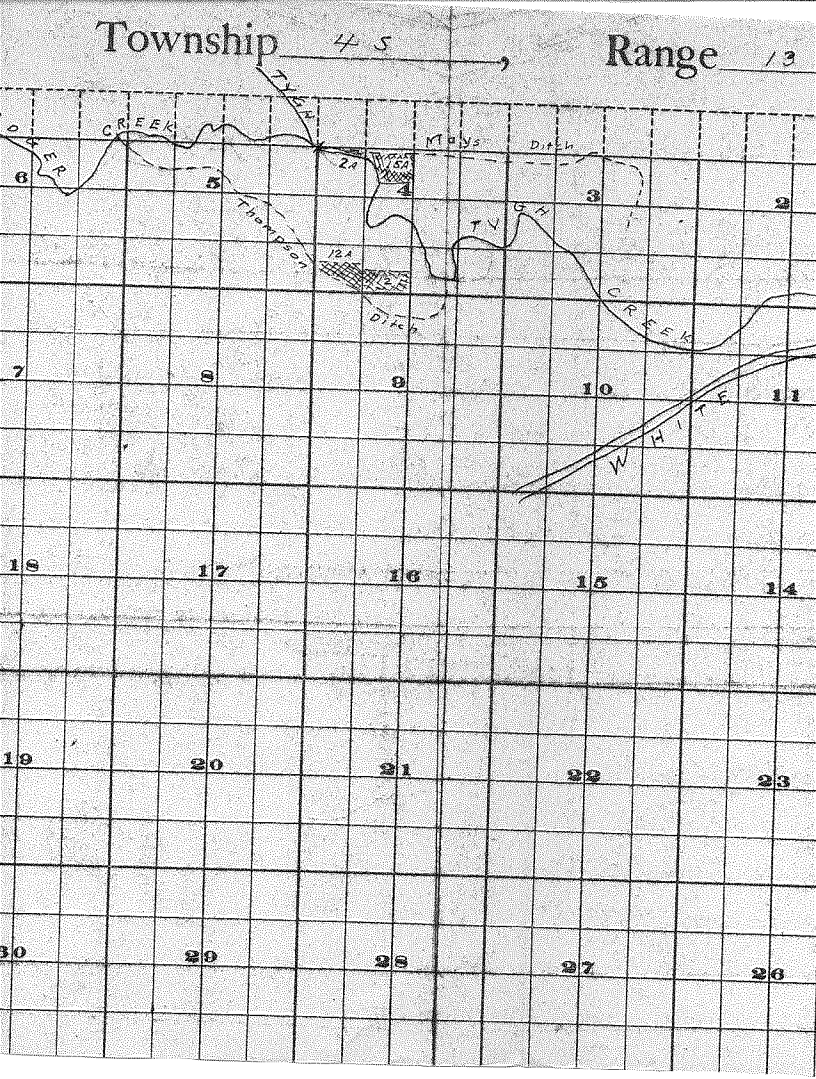
Township 45
Range 13
TYGH
CREEK
Mays Ditch
Thompson Ditch
TYGH CREEK
WHITE
2A
15A
12A
6
5
4
3
2
7
8
9
10
11
18
17
16
15
14
19
20
21
22
23
30
29
28
27
26