


SECTION

TOWNSHIP 45., RANGE 2E., W. M.

North

West

East

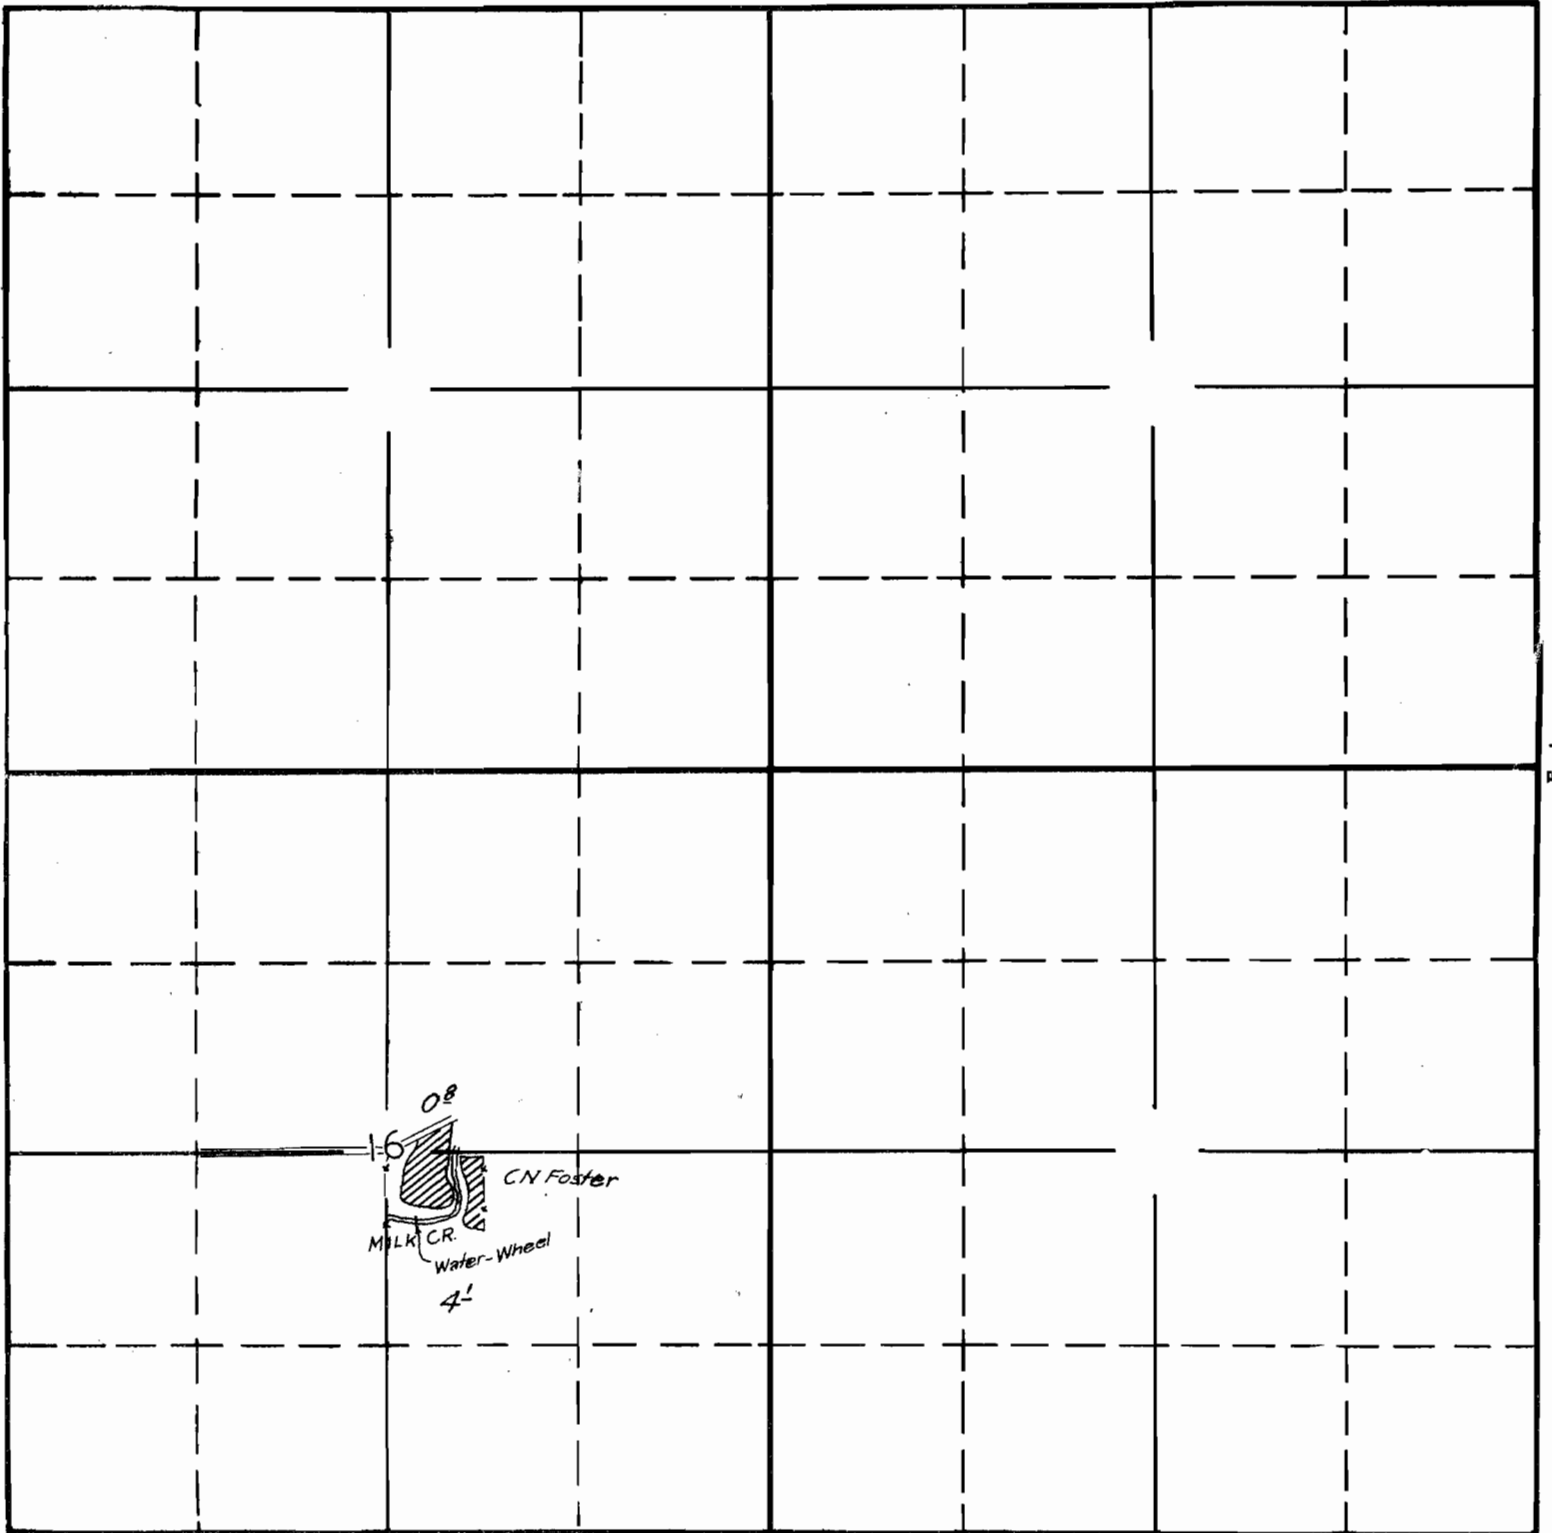

South

filed with prop

APPLICATION No. 15803

PERMIT No. 11652