


SECTION

12120

TOWNSHIP 2 N., RANGE 10 E., W. M.

North

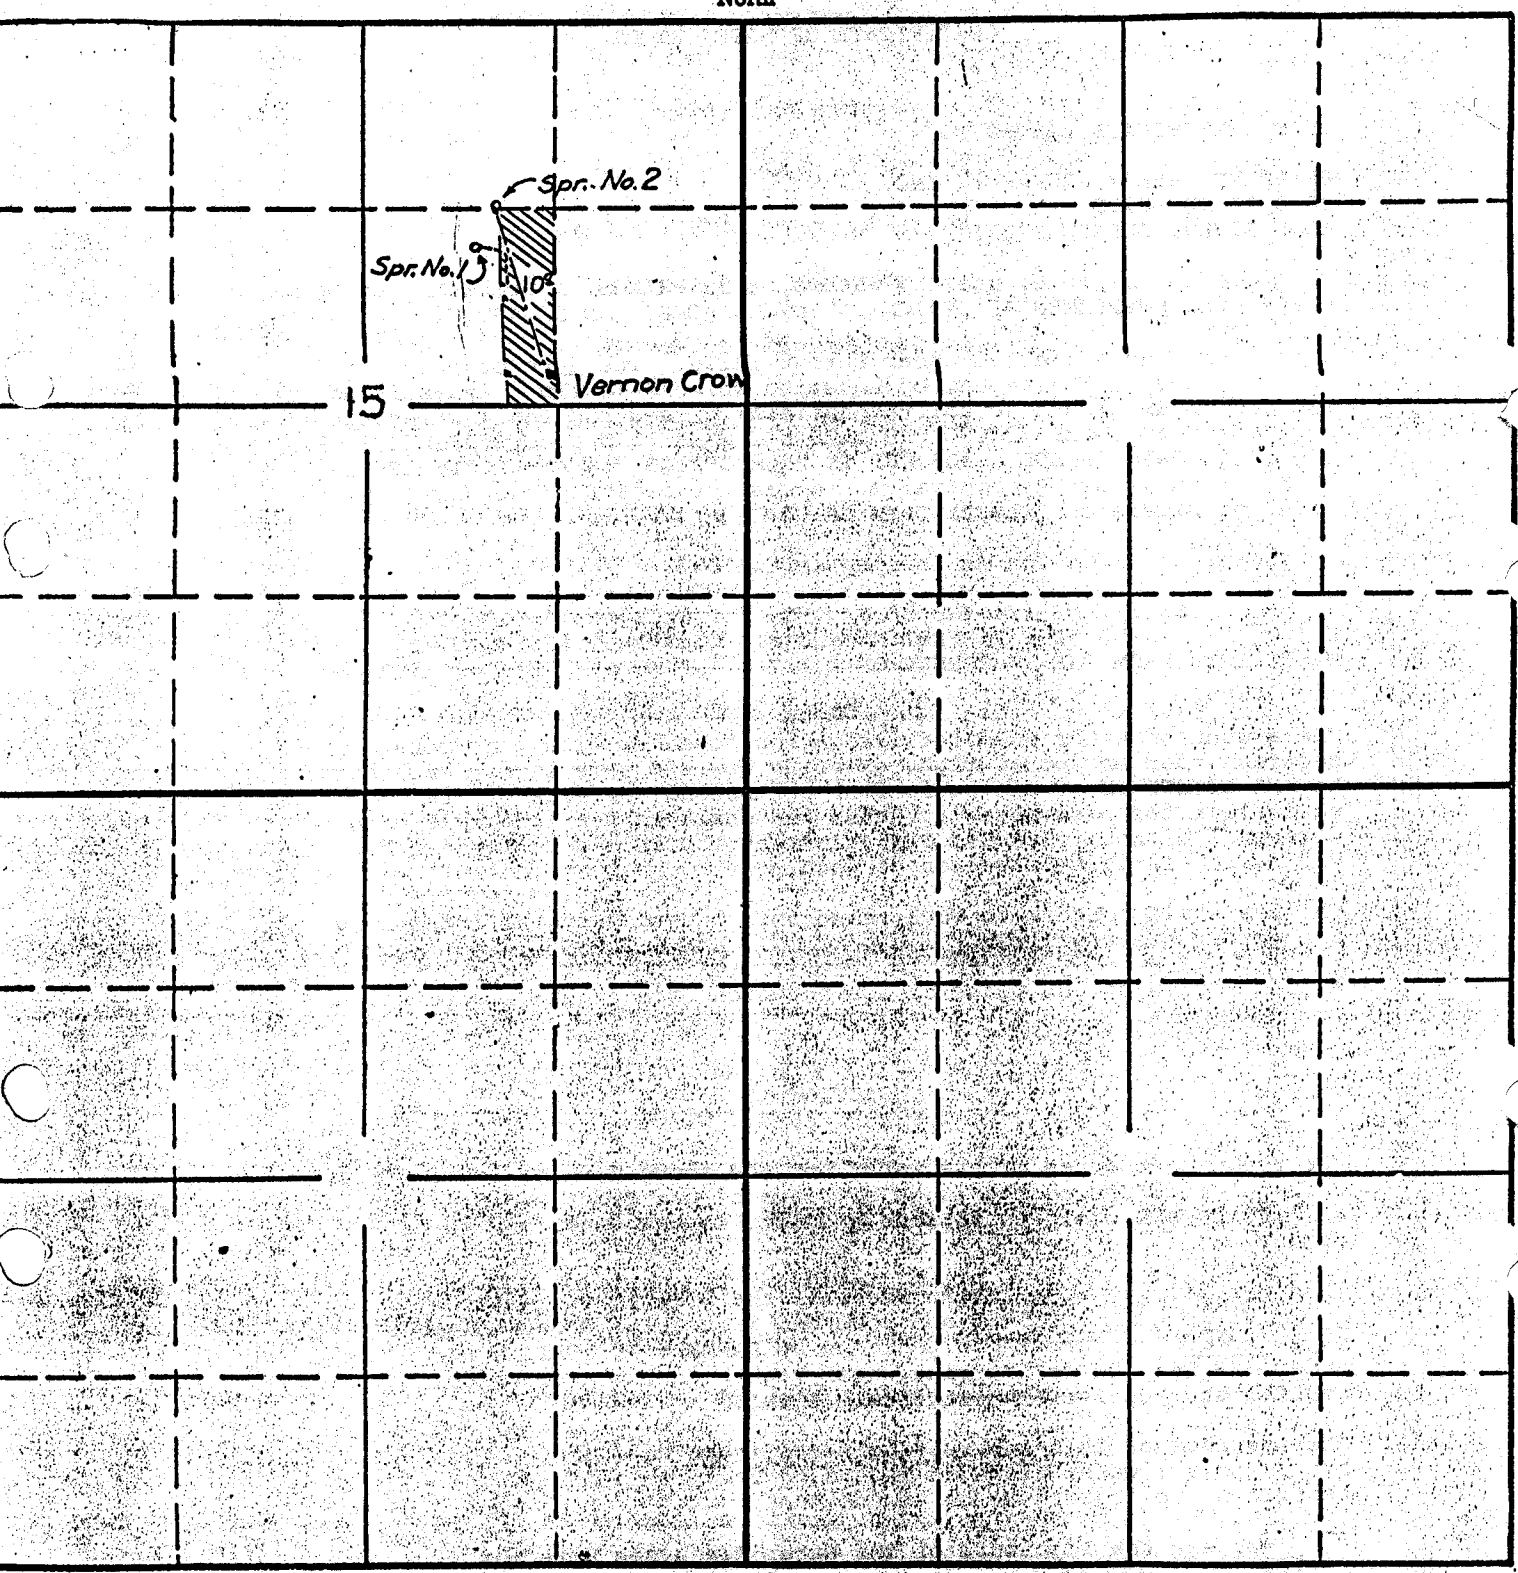

South

APPLICATION No. 16307

PERMIT No. 12120

Oct. 26 1937  
Aug