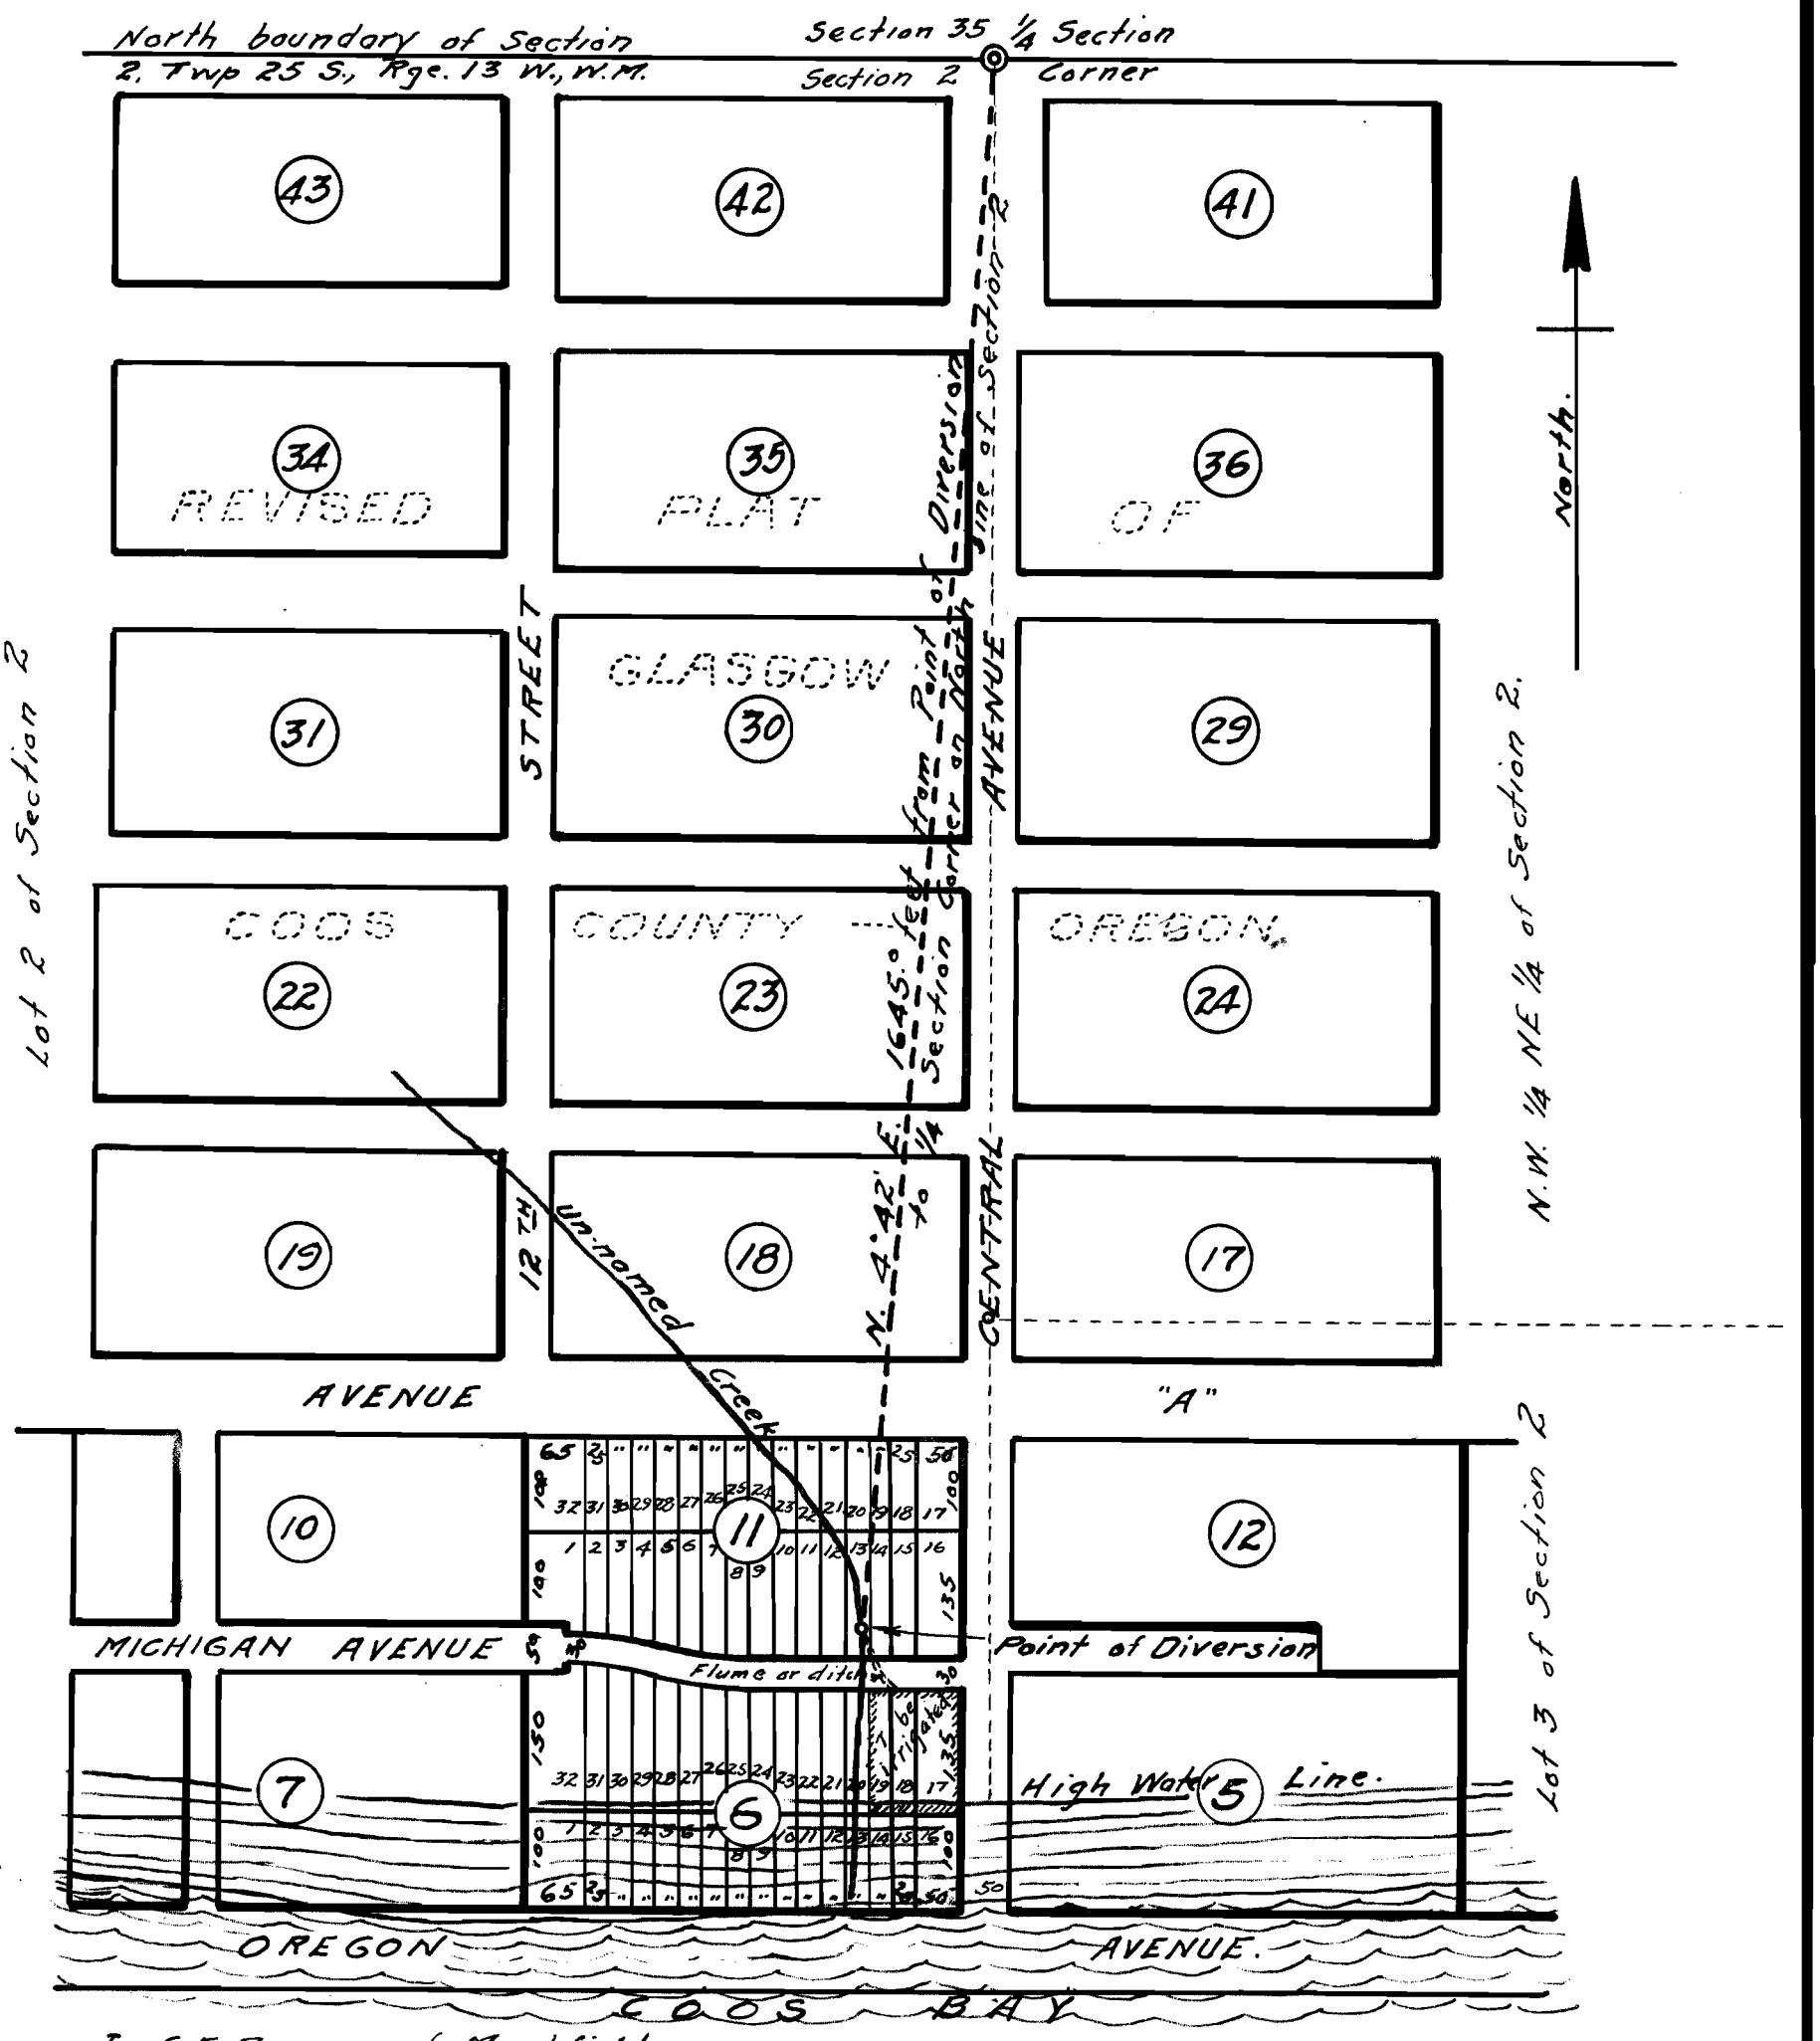

I, C.F. Bessee, of Marshfield, Oregon, do hereby certify that this map was made from notes taken during an actual survey made by me on the 2nd day of July, 1936, and that it correctly represents the Point of Diversion and the approximate location of the proposed ditch and flume to the point of use

C. F. Bessee.

App. No. 16404
Per. No. 12324

REGISTERED PROFESSIONAL ENGINEER
1286
C. F. Bessee.
OREGON
JULY 11, 1924
C. F. BESSEE

PLAN ACCOMPANYING APPLICATION OF

FRANK H. ROGERS

FOR RIGHT TO APPROPRIATE WATER FROM AN UN-NAMED STREAM IN LOT 2 OF SECTION 2, TP 25 S., RG. 13 W.

SCALE:- 1 INCH = 200 FEET.

Note:-
Lands to be irrigated are Lots, 17, 18 and 19, of Block 6, Revised Plat of Glasgow, Coos County, Oregon, containing 0.31 acres.