

Sec. 10


SW NW

Tp. 39 S

R. 20 E W M

7-78
12008

Mill #1
Well #2
N12° 32' E
1197'

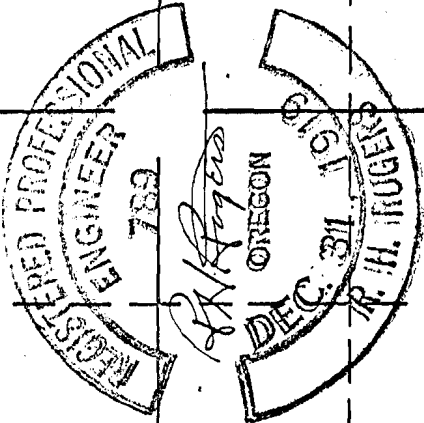

Plat made from notes taken on the Mill layout survey May 1933
by R. H. Rogers.

App. No. 76-82
Per. No. 76-78

