

SECTION

U-79
12009


TOWNSHIP 39 S RANGE 20 E, W. M.

Well #2.

North

Plot made from measurements made by

R.H. Rogers
April 4 1934.

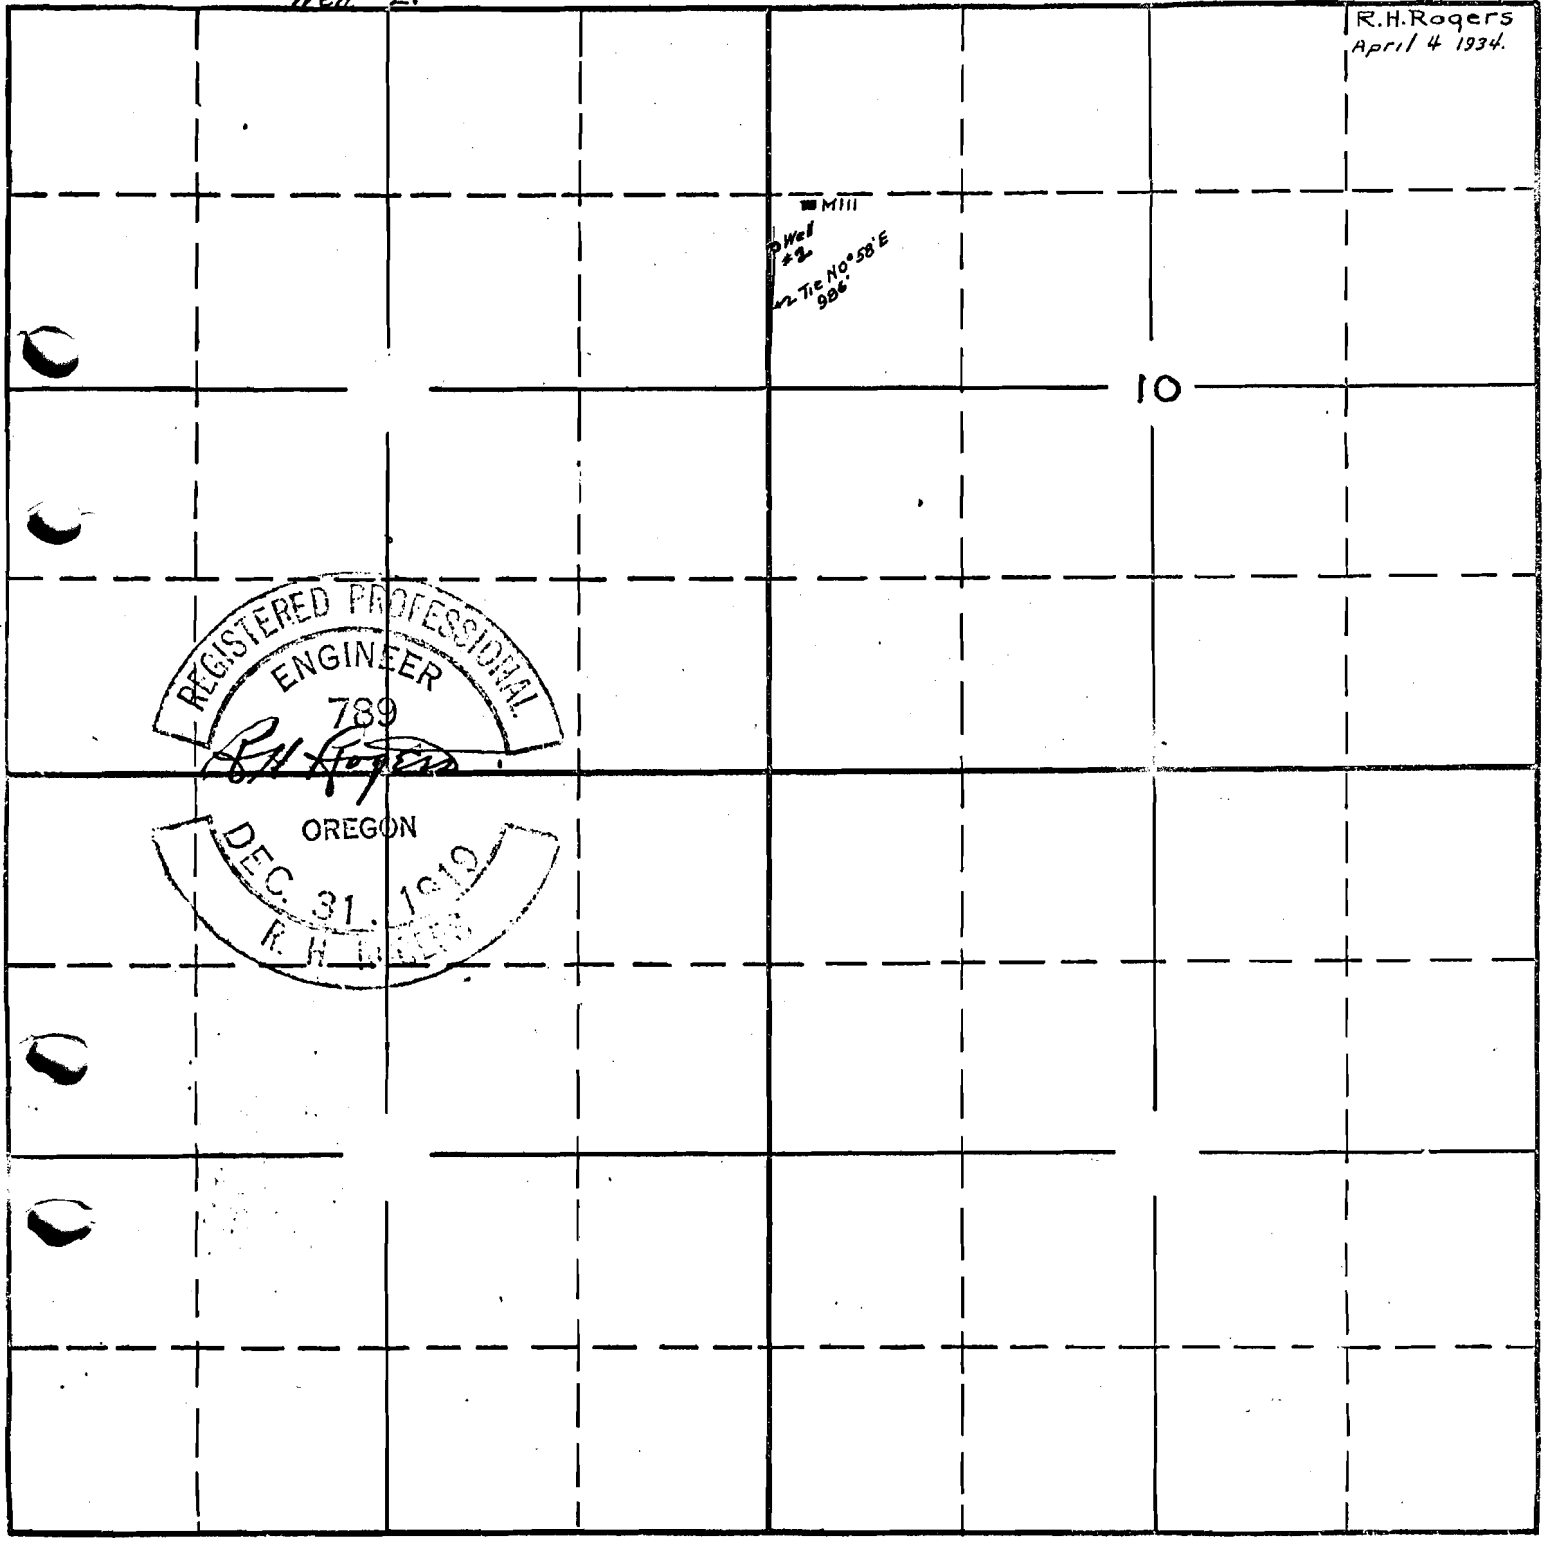

South

RECEIVED
APR 6 1934

APPLICATION No. U-83
PERMIT No. U-79

GRASS ENGINEER

