RECEIVED
DEC 29 1937
STATE ENGINEER
SALEM, OREGON

MAP

To accompany the application of The Town of

~~Lakeview Oregon, for Well number Three.~~

R.H.Rogers Lakeview Oregon. Registered Professional Eng'r No789.

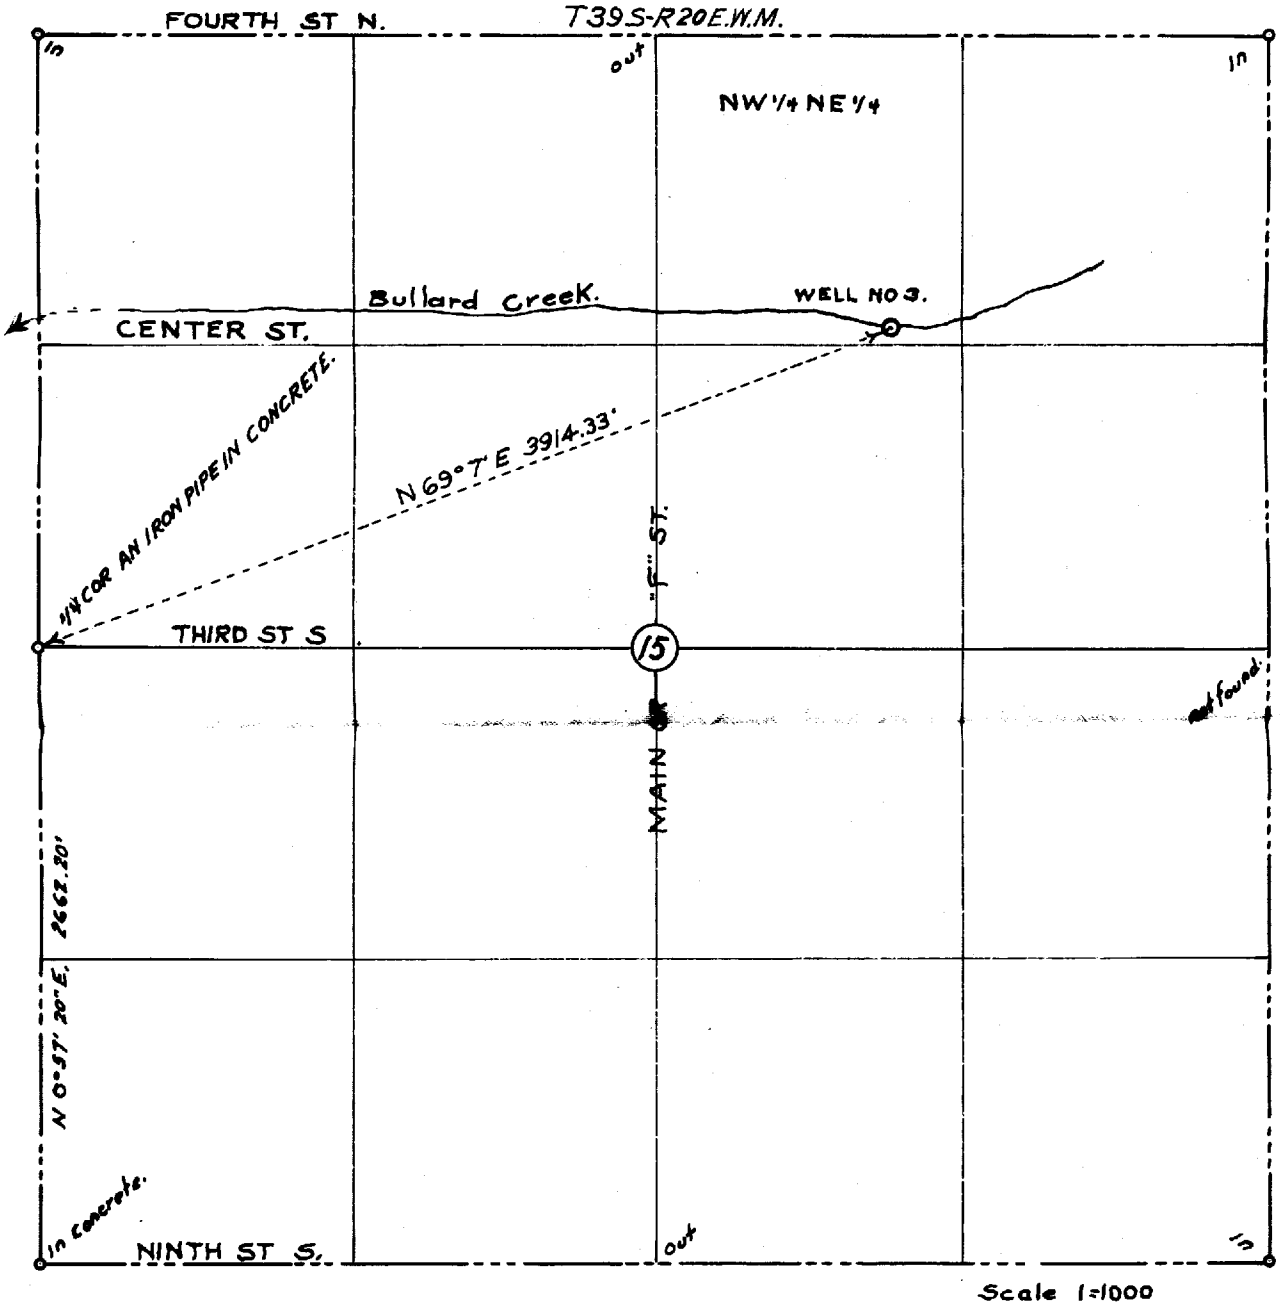

Scale 1=1000

U-112 OK
13-26

Application No. U-112
Permit No. U-105