


Gold Channel Mining Co.

H.R. Sanderson

Scale 4" = 1 Mile

Dec. 1934

54-7

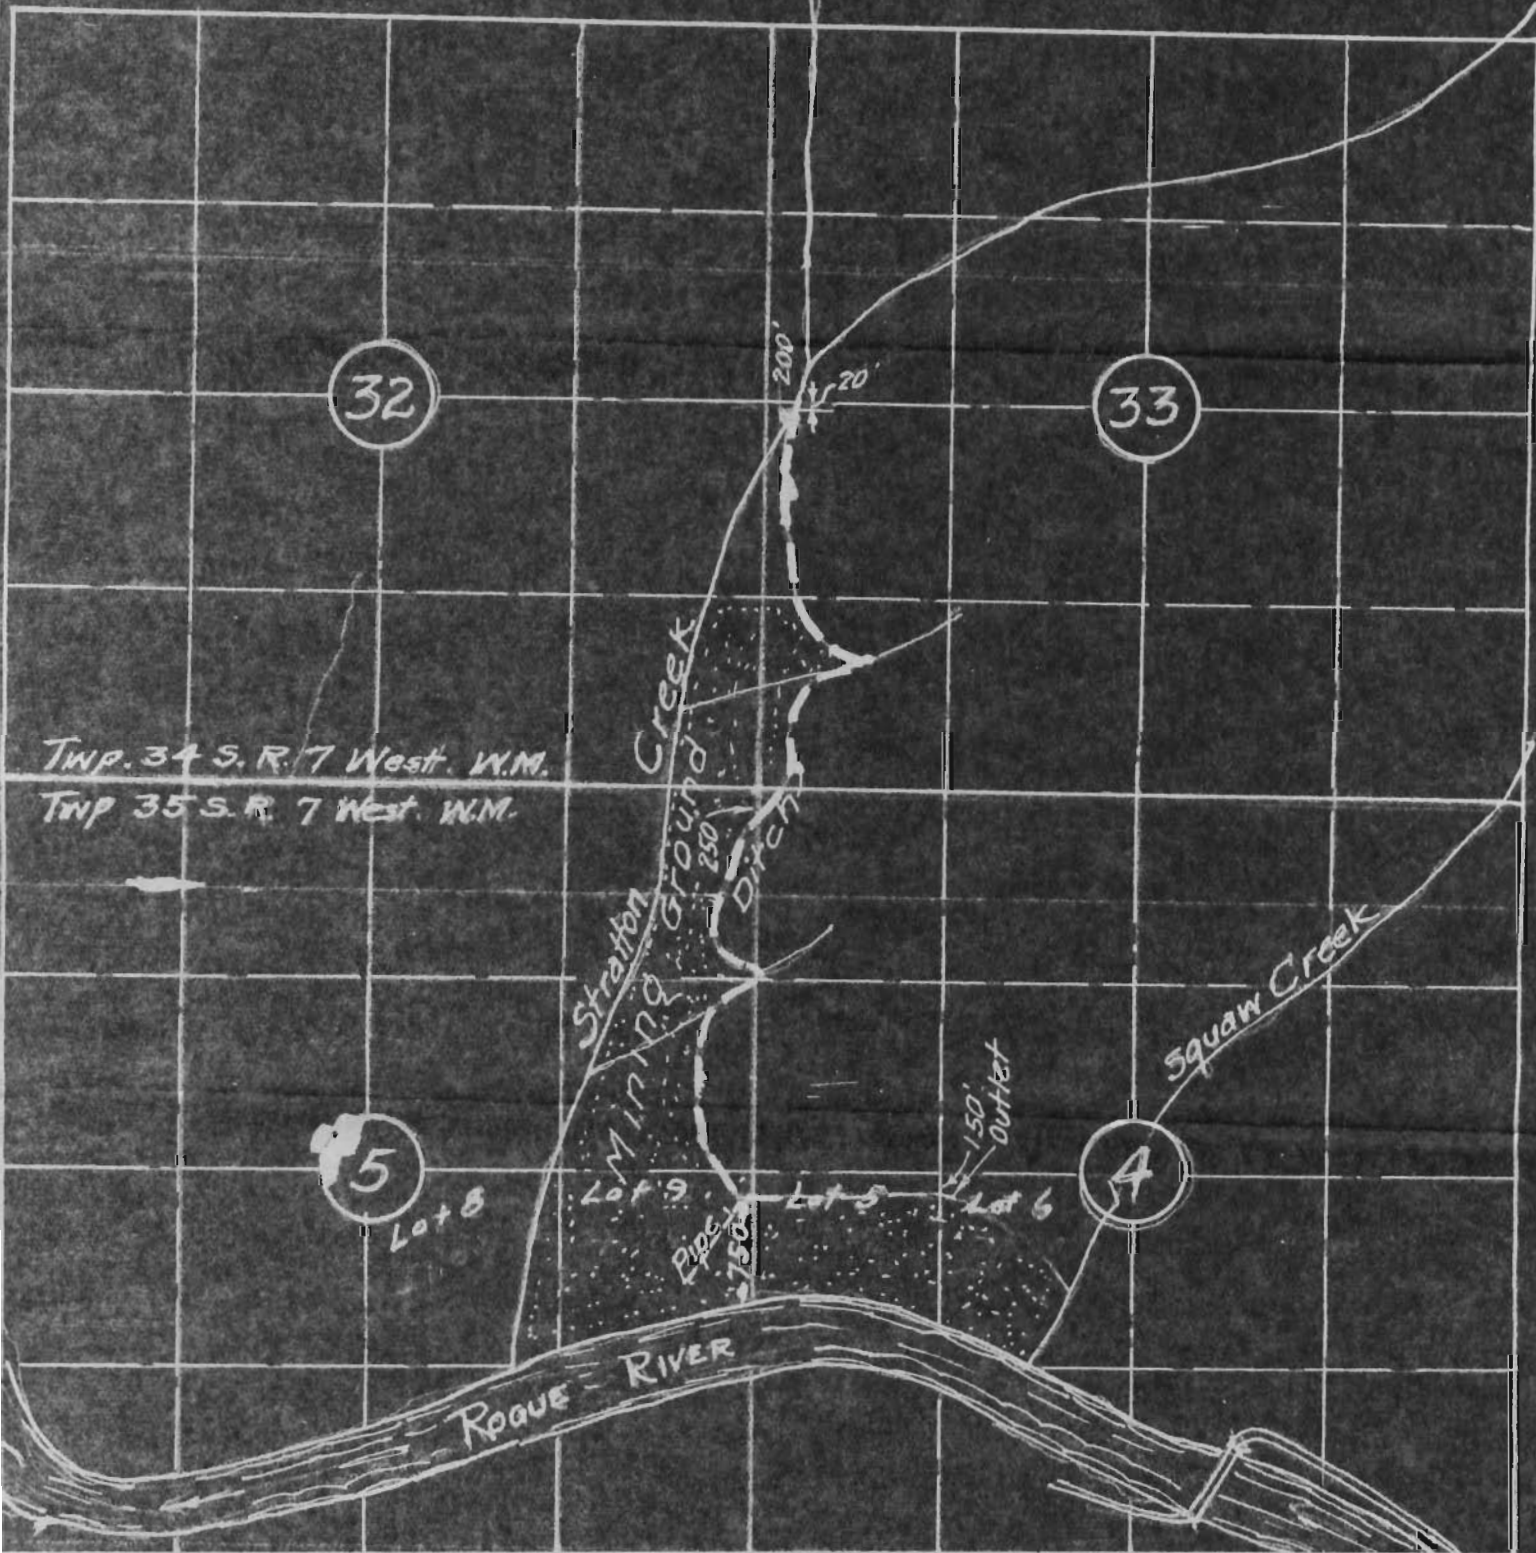

N

I, Tom R. Pearce, of Grants Pass, Oregon do hereby certify that this map was made from notes taken during an actual survey made under my supervision on Dec. 17, 1934 and that it correctly represents the work described in the accompanying application together with the location of streams and ditches in the immediate vicinity.



App. No. 15661
Per. No. 11529