


2428

SEC. 1 TOWNSHIP 40 SOUTH, RANGE 20 E.W.M.

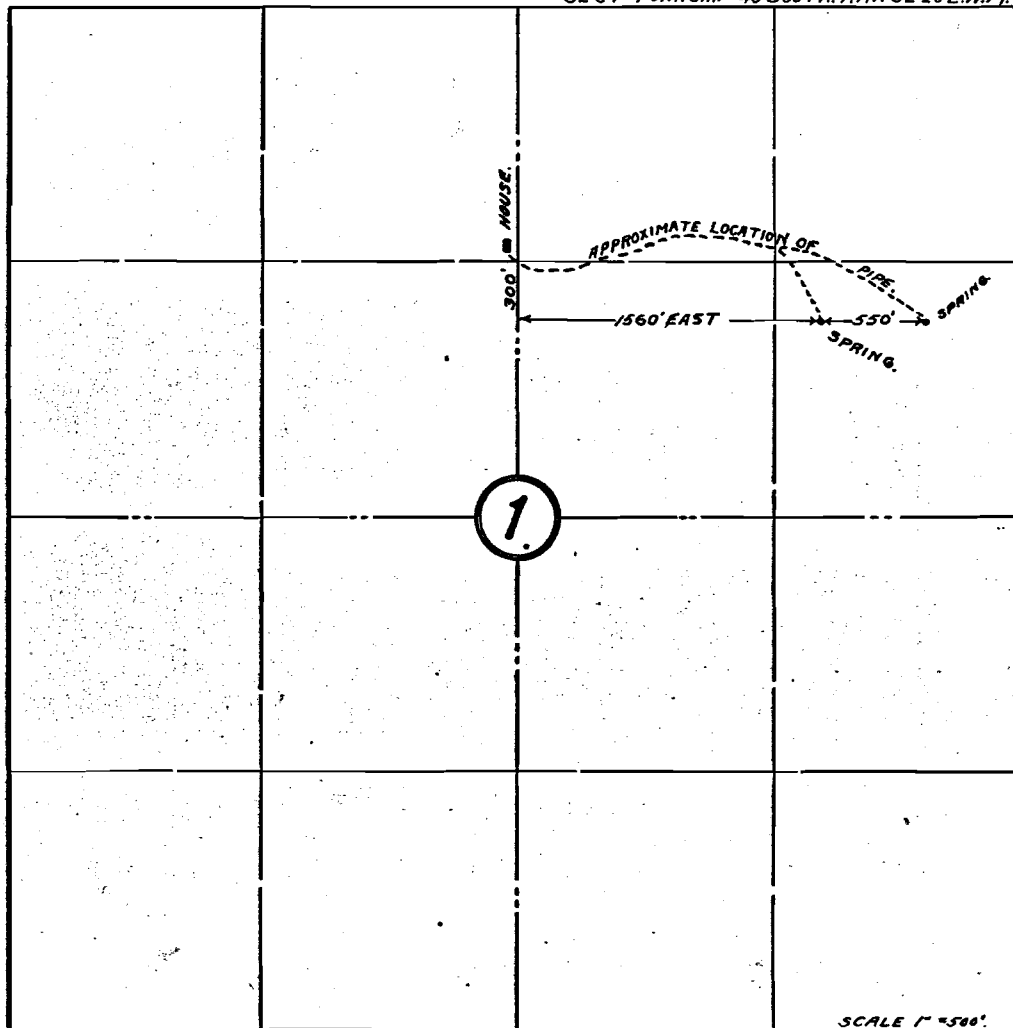

MAP

Made from notes furnished by applicant, showing the approximate location of springs and pipeline to house.

OFFICE OF STATE ENGINEER
RECEIVED
MAY 12 1911
SALEM, - OREGON

Application No. 3648
Permit No. 2153

From Office of
S.A. Mushen, Lakeview, Ore.

2428

2428

2153
C1208