T.9.S. R.15 E. W.M.

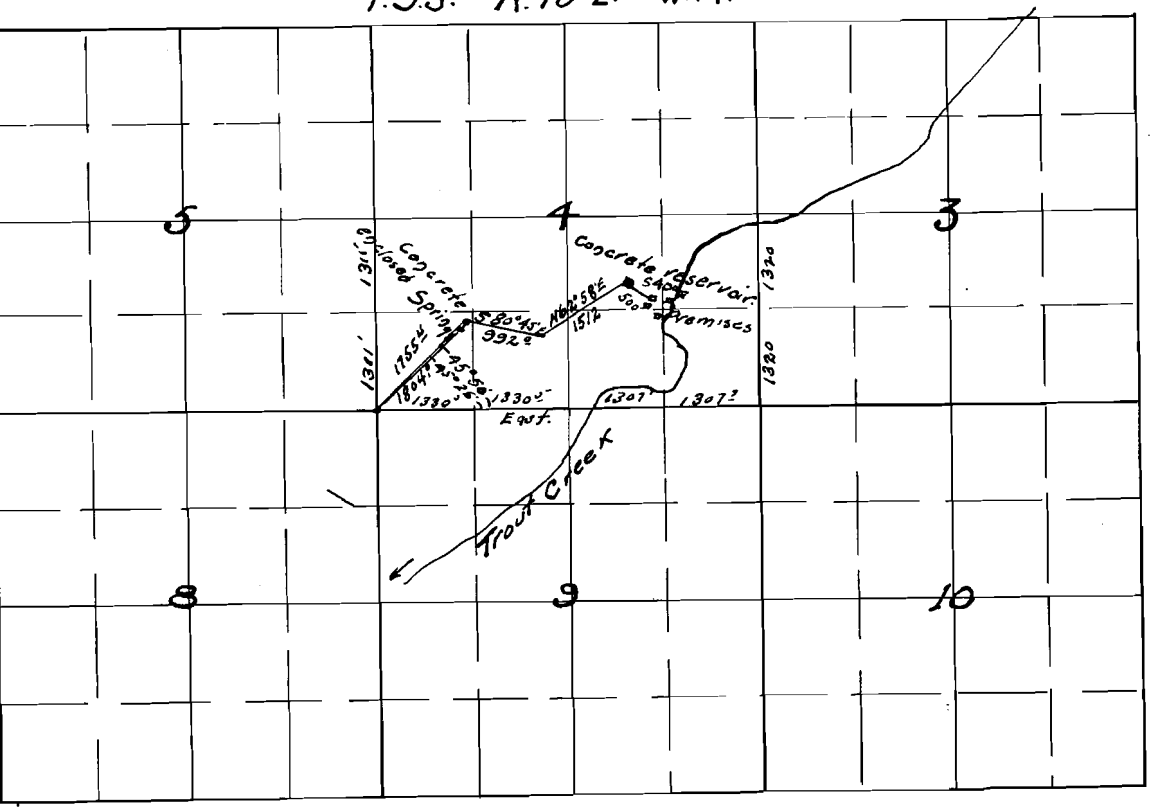

Survey of the

John E. Bolter.

Pipeline.

Scale 40 chs. to the Inch —.

I, F. I. Phoenix, of Redmond, Crook County, Oregon, do hereby certify that this map was made from the field-notes of an actual survey made by me on June 6th 1914 and it correctly represents the work described in the accompanying application, together with the location of streams in the vicinity.

F. I. Phoenix
Surveyor.

RECEIVED
JUN 19 1914
SALEM, OREGON.

3733
2150