

SECTION

\_\_\_\_\_

\_\_\_\_\_

\_\_\_\_\_


\_\_\_\_\_

P. 11192

12096

TOWNSHIP 13S, RANGE 26E, W. M.

North

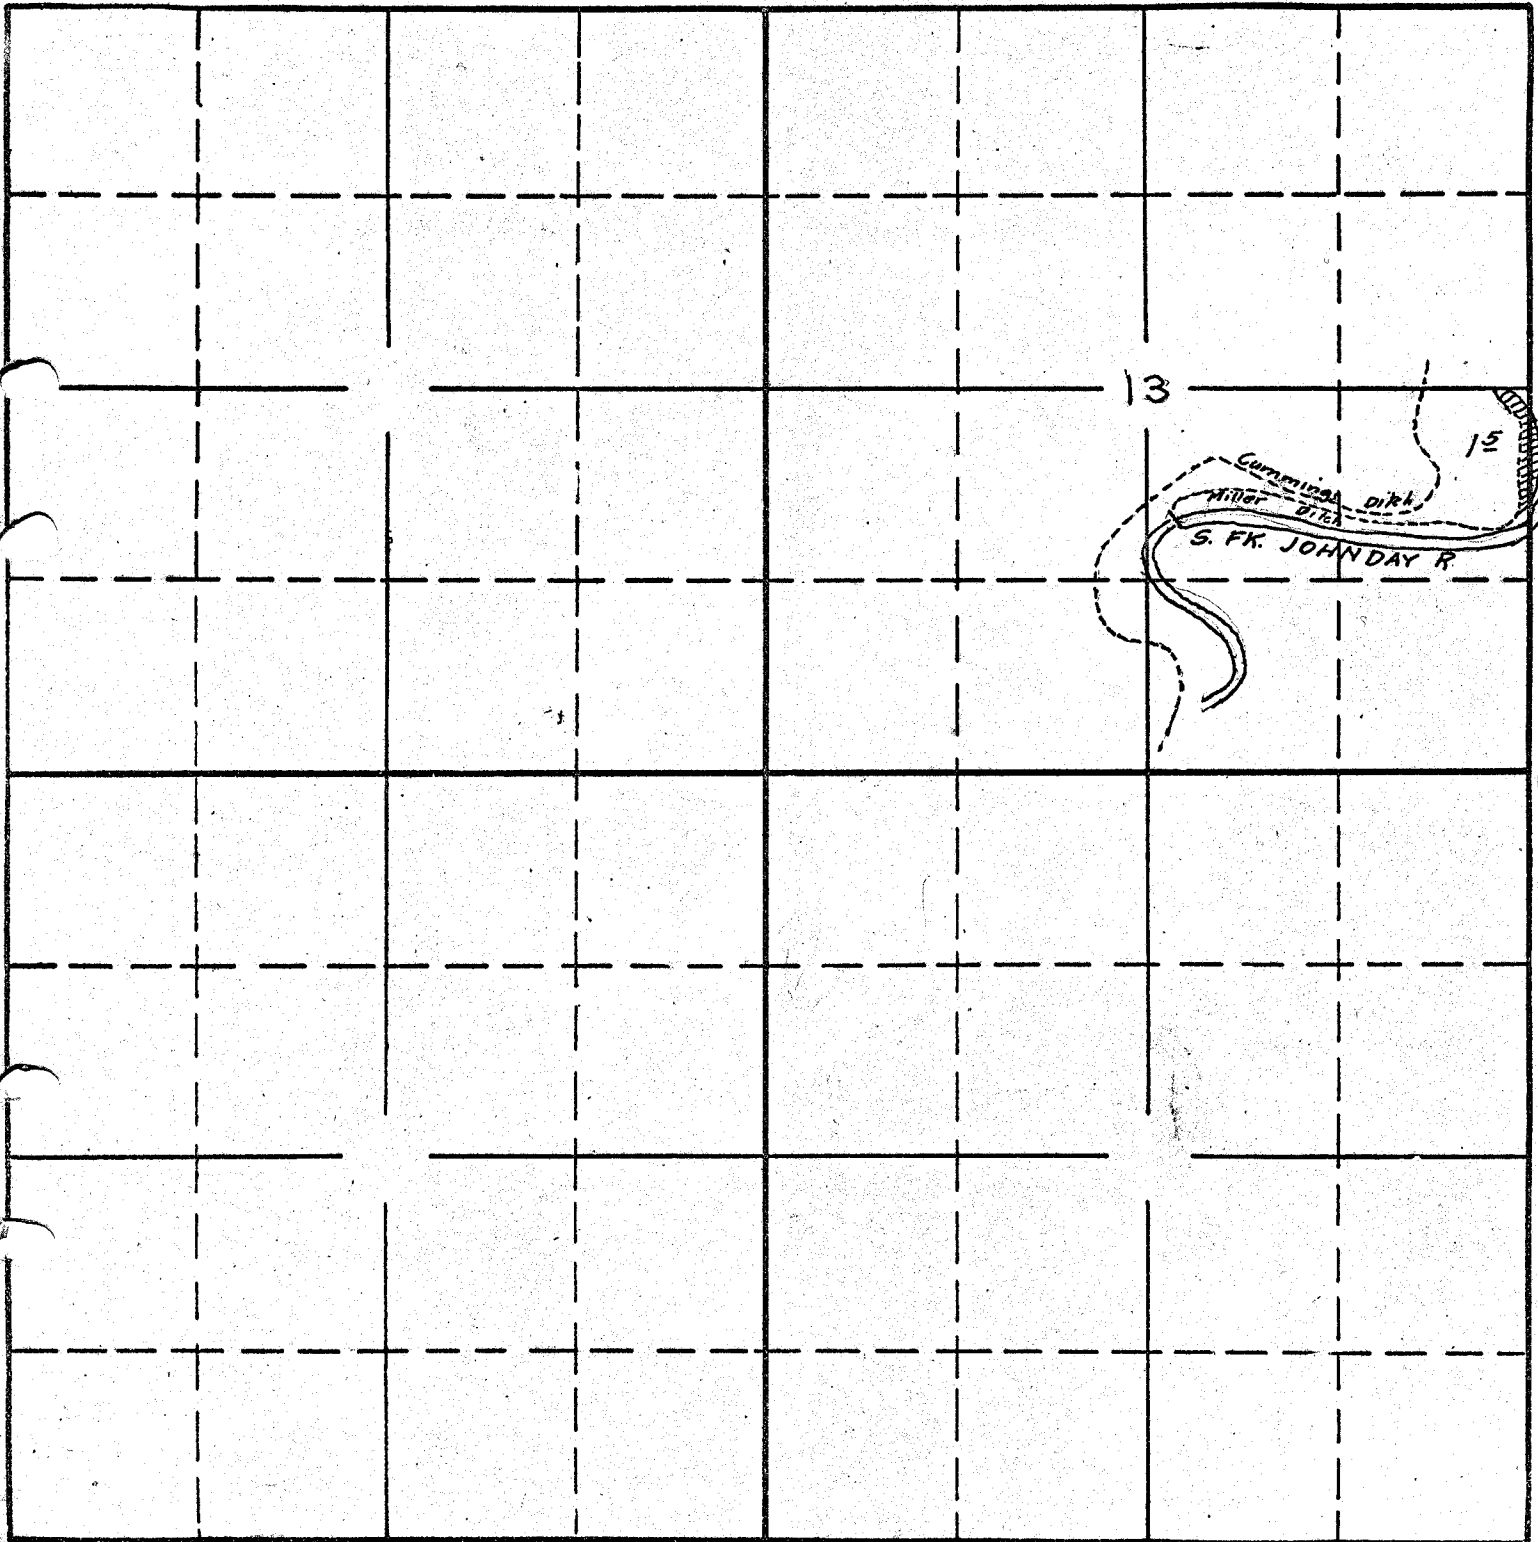

South

APPLICATION No. 15281

PERMIT No. 11192