


SECTION

D 11249

12104

TOWNSHIP 13, RANGE 31, W. M.

North

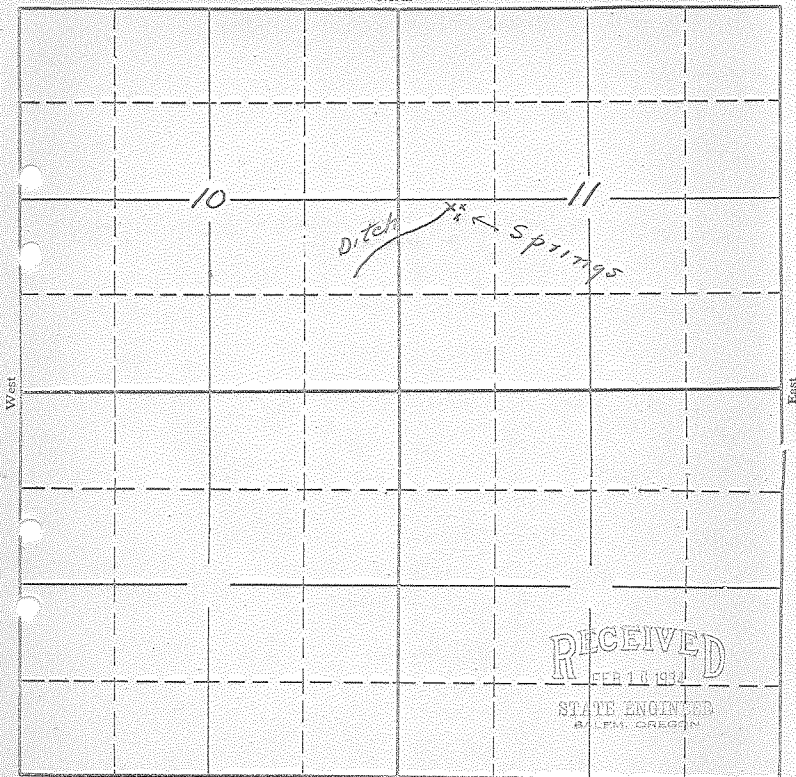

South

APPLICATION No. 15272

PERMIT No. 11249