

SECTION

\_\_\_\_\_


\_\_\_\_\_

\_\_\_\_\_

\_\_\_\_\_

TOWNSHIP 33S, RANGE 1W, W. M.

North

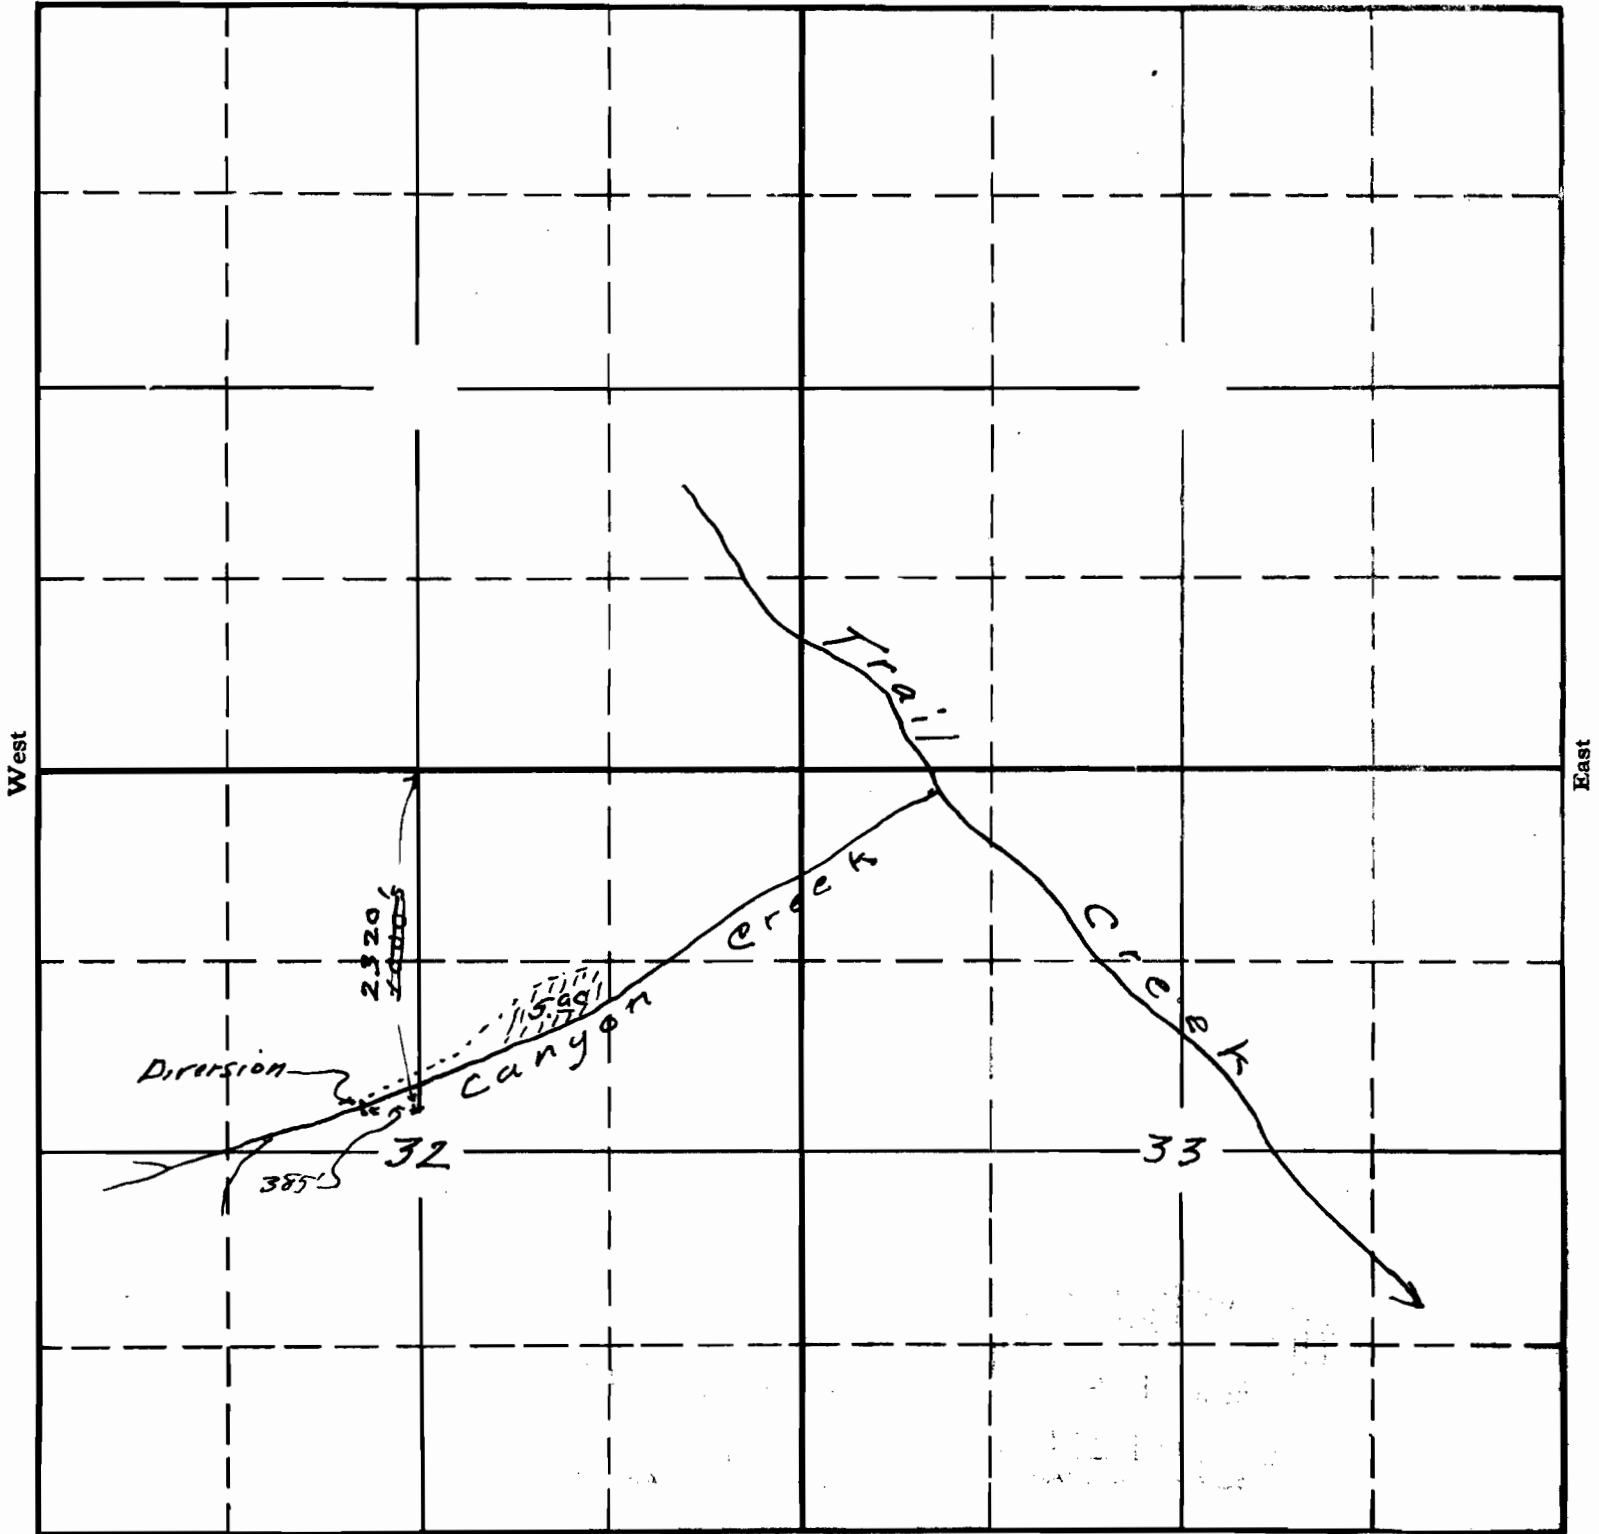

Map to accompany application of  
 Thelma Pauline Inlow for the  
 appropriation of the waters of  
 Canyon Cr. for the irrigation of 5.65  
 Made from notes furnished by M. Inlow

APPLICATION No. 15780  
 PERMIT No. 11640