


SECTION

\_\_\_\_\_  
\_\_\_\_\_  
\_\_\_\_\_  
\_\_\_\_\_

TOWNSHIP \_\_\_\_\_, RANGE \_\_\_\_\_, W. M.

North

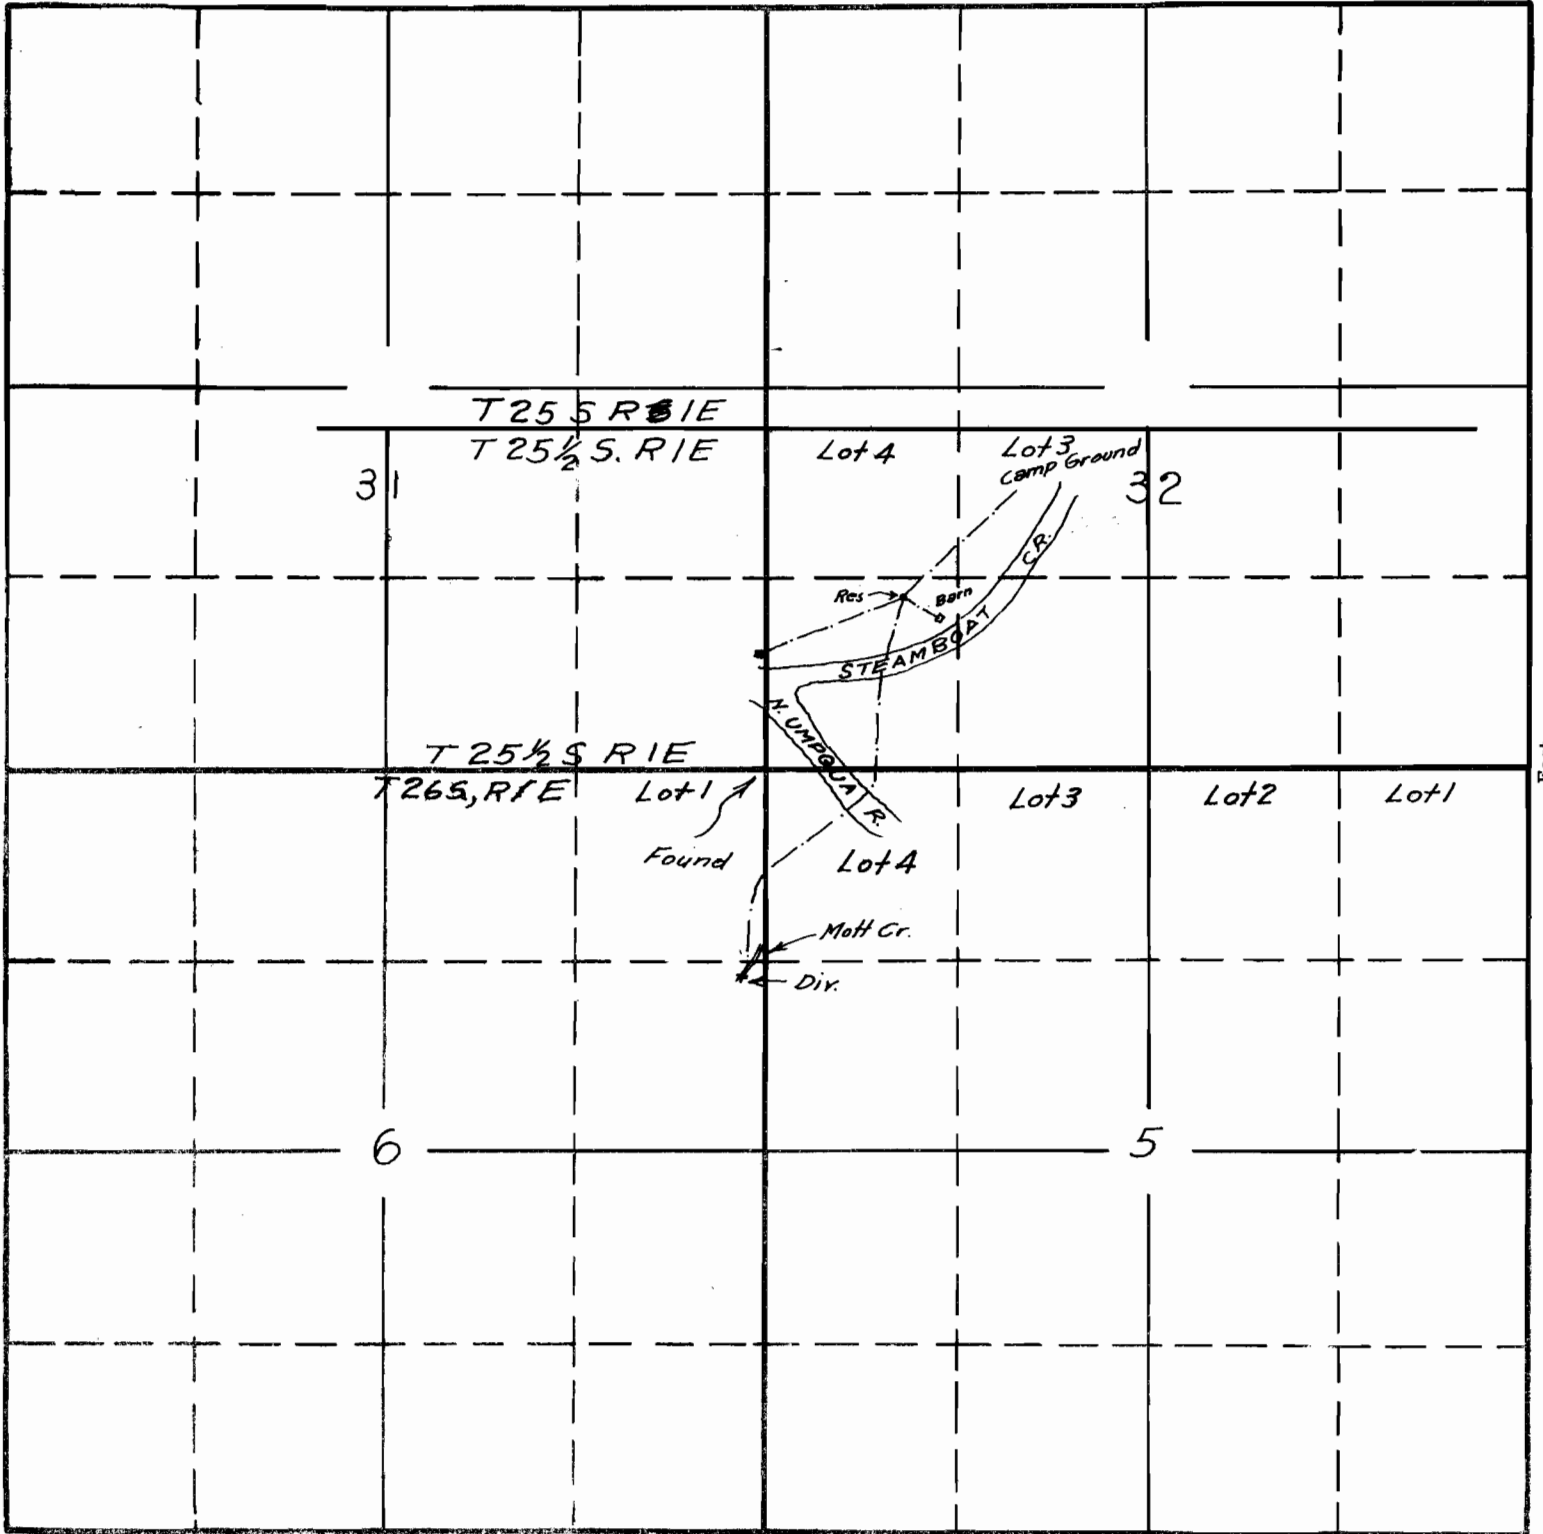

South

APPLICATION No. 16263  
PERMIT No. 12067