


TOWNSHIP 105, RANGE 2W, W. M.

North

West

East

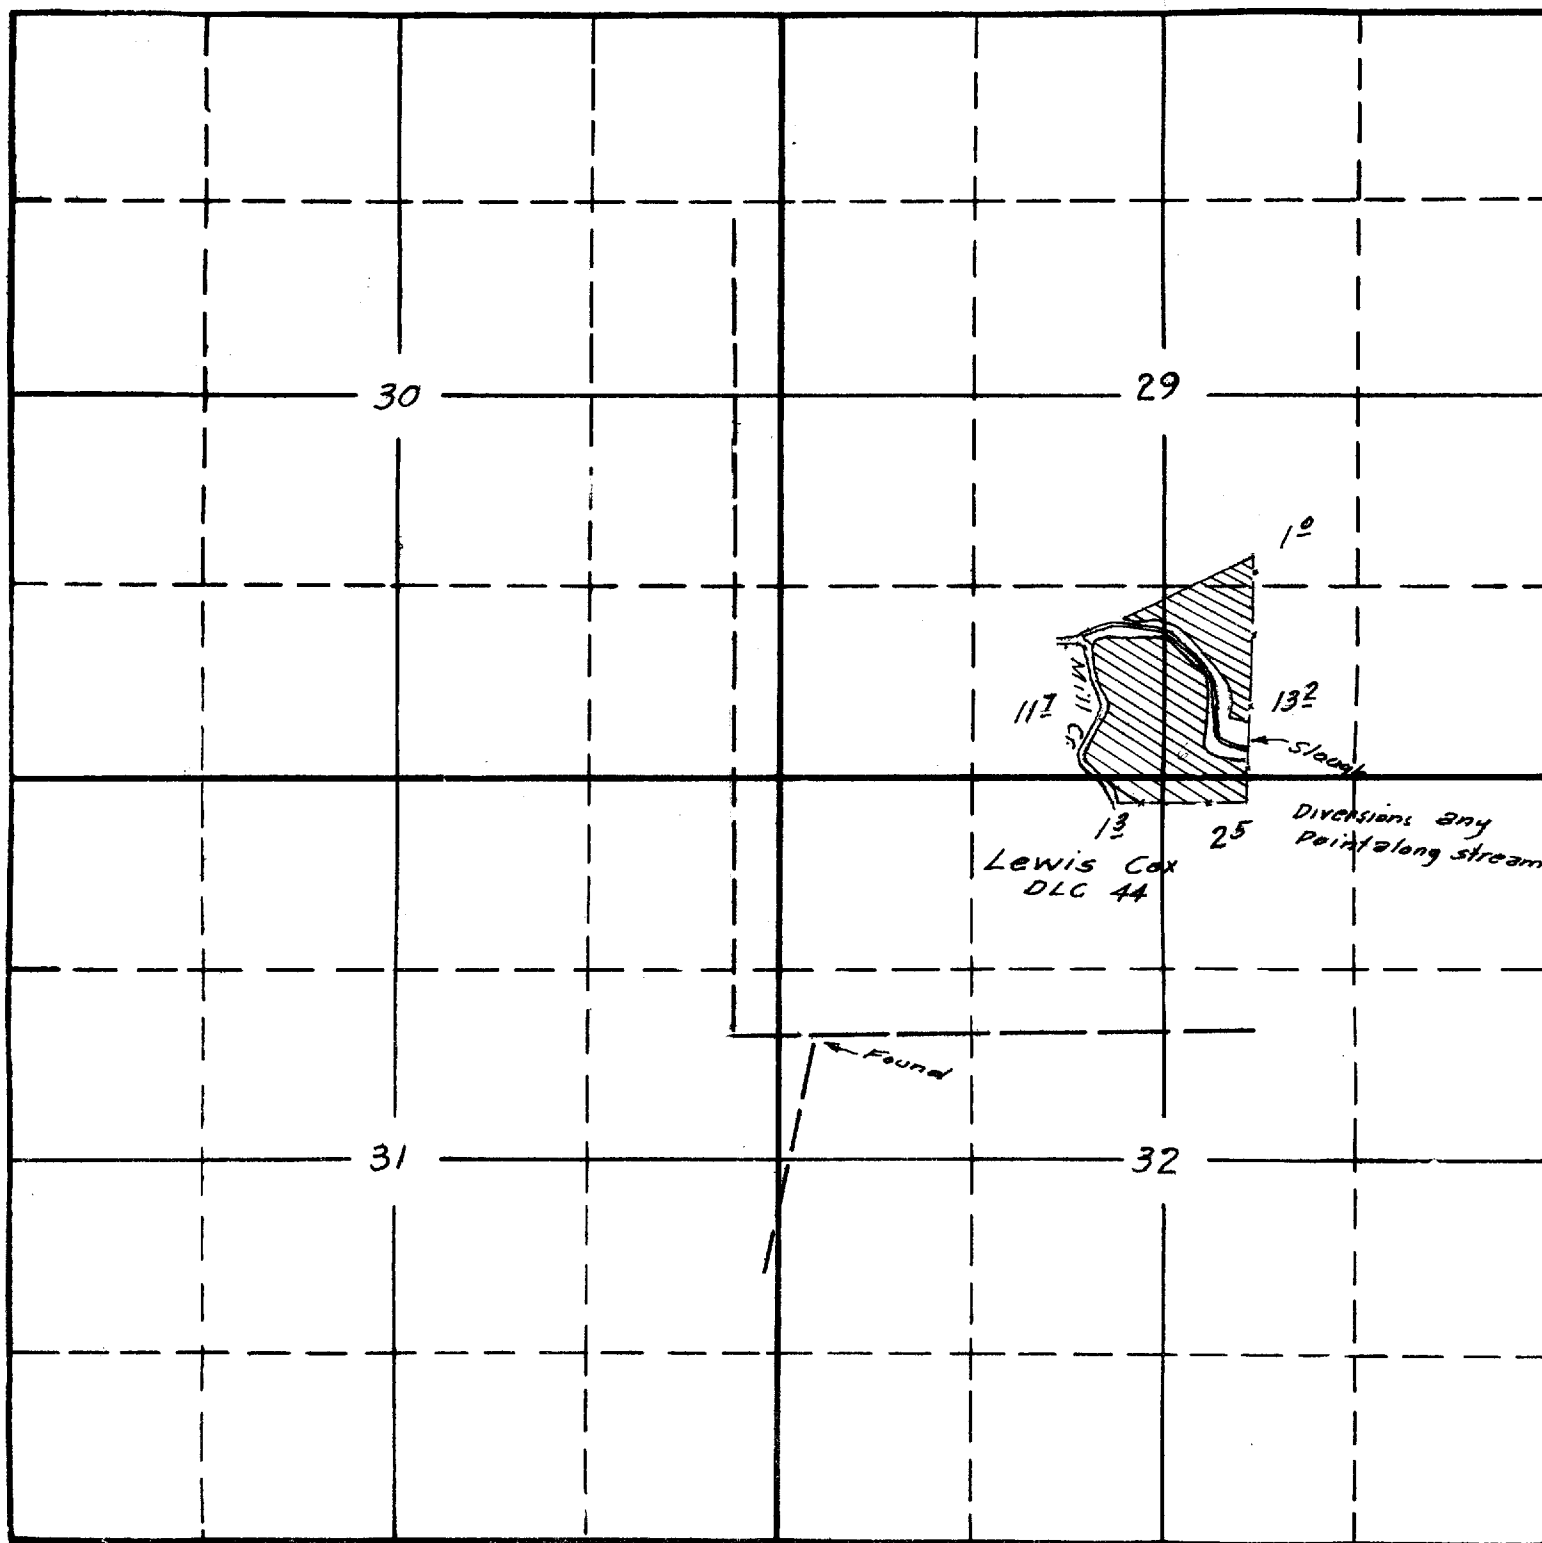

South

APPLICATION No. 16480

PERMIT No. 12283