


C12167

TOWNSHIP 18 S, RANGE 18 E, W. M.

North

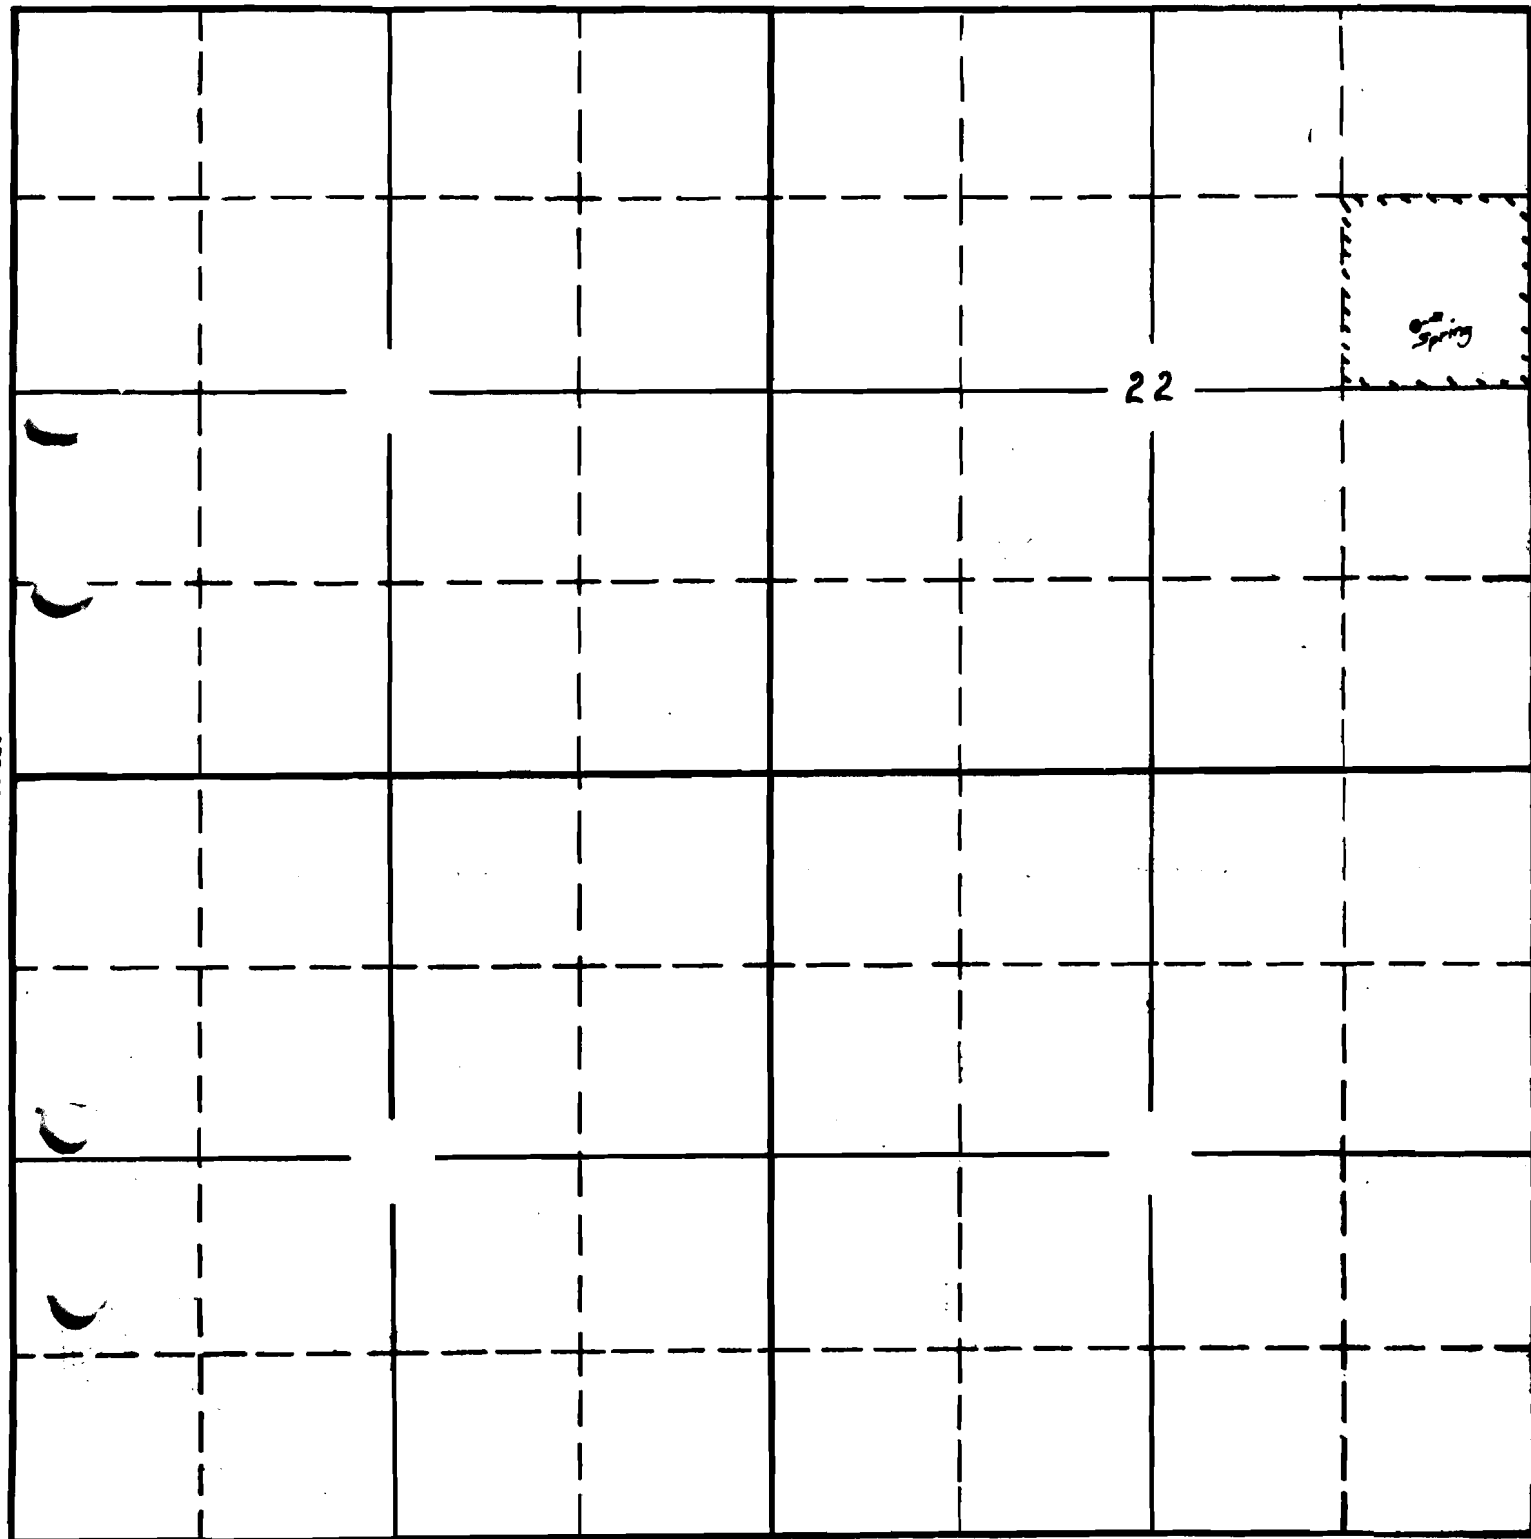

Copied from applicant's
sketch - 12/14/36 -

South

5-4-16571-OK
APPLICATION No. 16571
PERMIT No. 12468

This copy
O.K.

O. Rambow
12468