

Point of Diversion

NW 1/4 SW 1/4 Section 23

Un-named creek.
765' 1 1/2" Pipe

SW 1/4 SW 1/4 Section 23.

1986.5 feet
N 19° 20' E

2.25 Acres to be irrigated by ditches from pipe line

Barn

Secondary State Highway.

To North Fork of Coos River.

I, C. F. Bessee, of Marshfield, Oregon, do hereby certify that this map was made from notes taken during an actual survey made by me on the 27th day of November, 1936, and that it correctly represents the point of diversion, the creeks in the immediate vicinity thereof, and the approximate location of the pipe line to the point of use.


C. F. Bessee.

PLAN ACCOMPANYING APPLICATION OF
MRS. SARAH DAVIS

FOR RIGHT TO APPROPRIATE WATER
FROM AN UN-NAMED STREAM IN
NW 1/4 SW 1/4 OF SECTION 23, TP. 25S., RG. 12W., W.M.

SCALE: 1 INCH = 100 FEET.

17-10-16700
Application No. 16700
Permit No. 12488

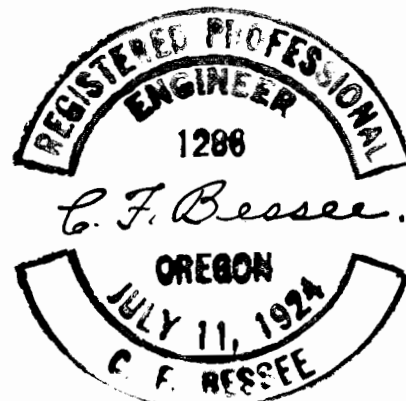

Section
27/26 Corner.