


11.22
007
07854

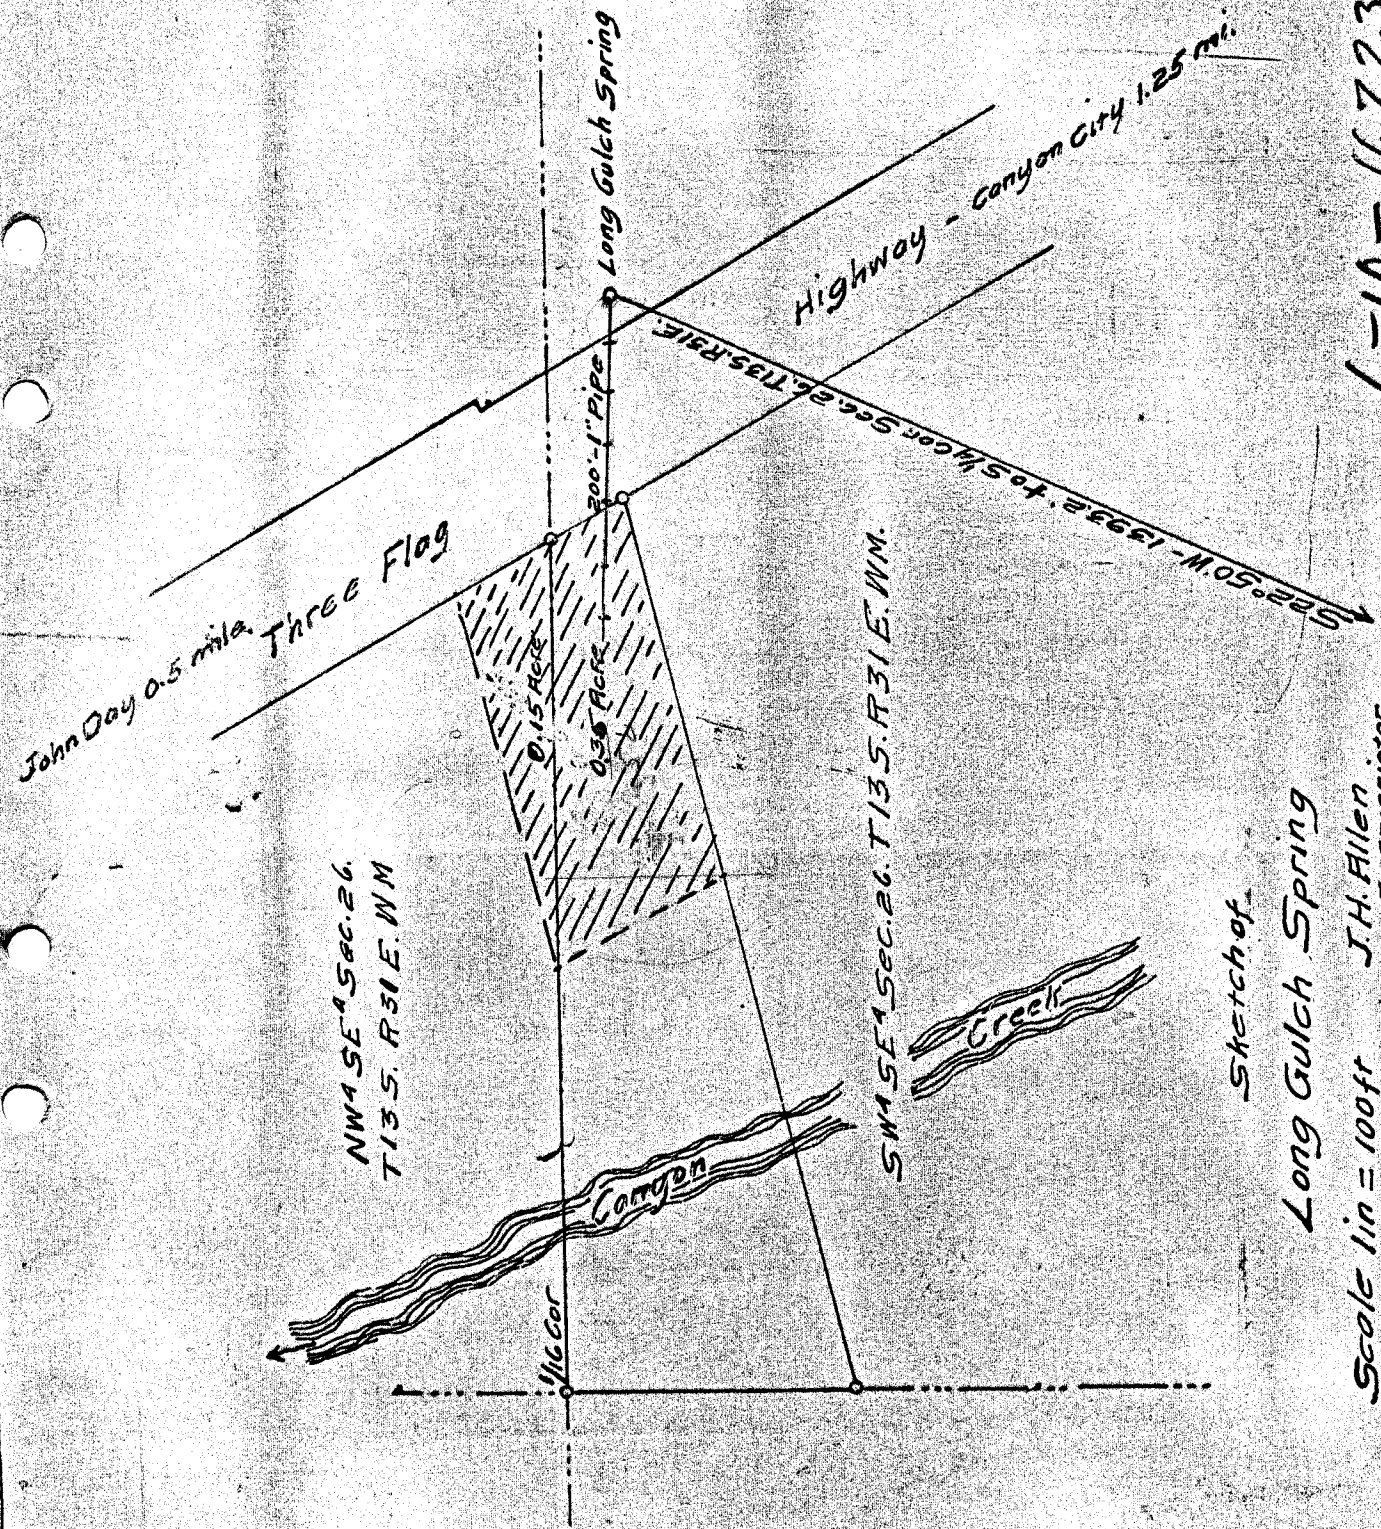

Application No. 6-10-16723-OK
96723
Permit No. 12508

Sketch of

Long Gulch Spring

J.H. Allen
Appropriator

Scale 1 in = 100 ft