

SECTION

\_\_\_\_\_

\_\_\_\_\_

\_\_\_\_\_


\_\_\_\_\_

P. 12736

12191

TOWNSHIP 8S, RANGE 19E., W. M.

North

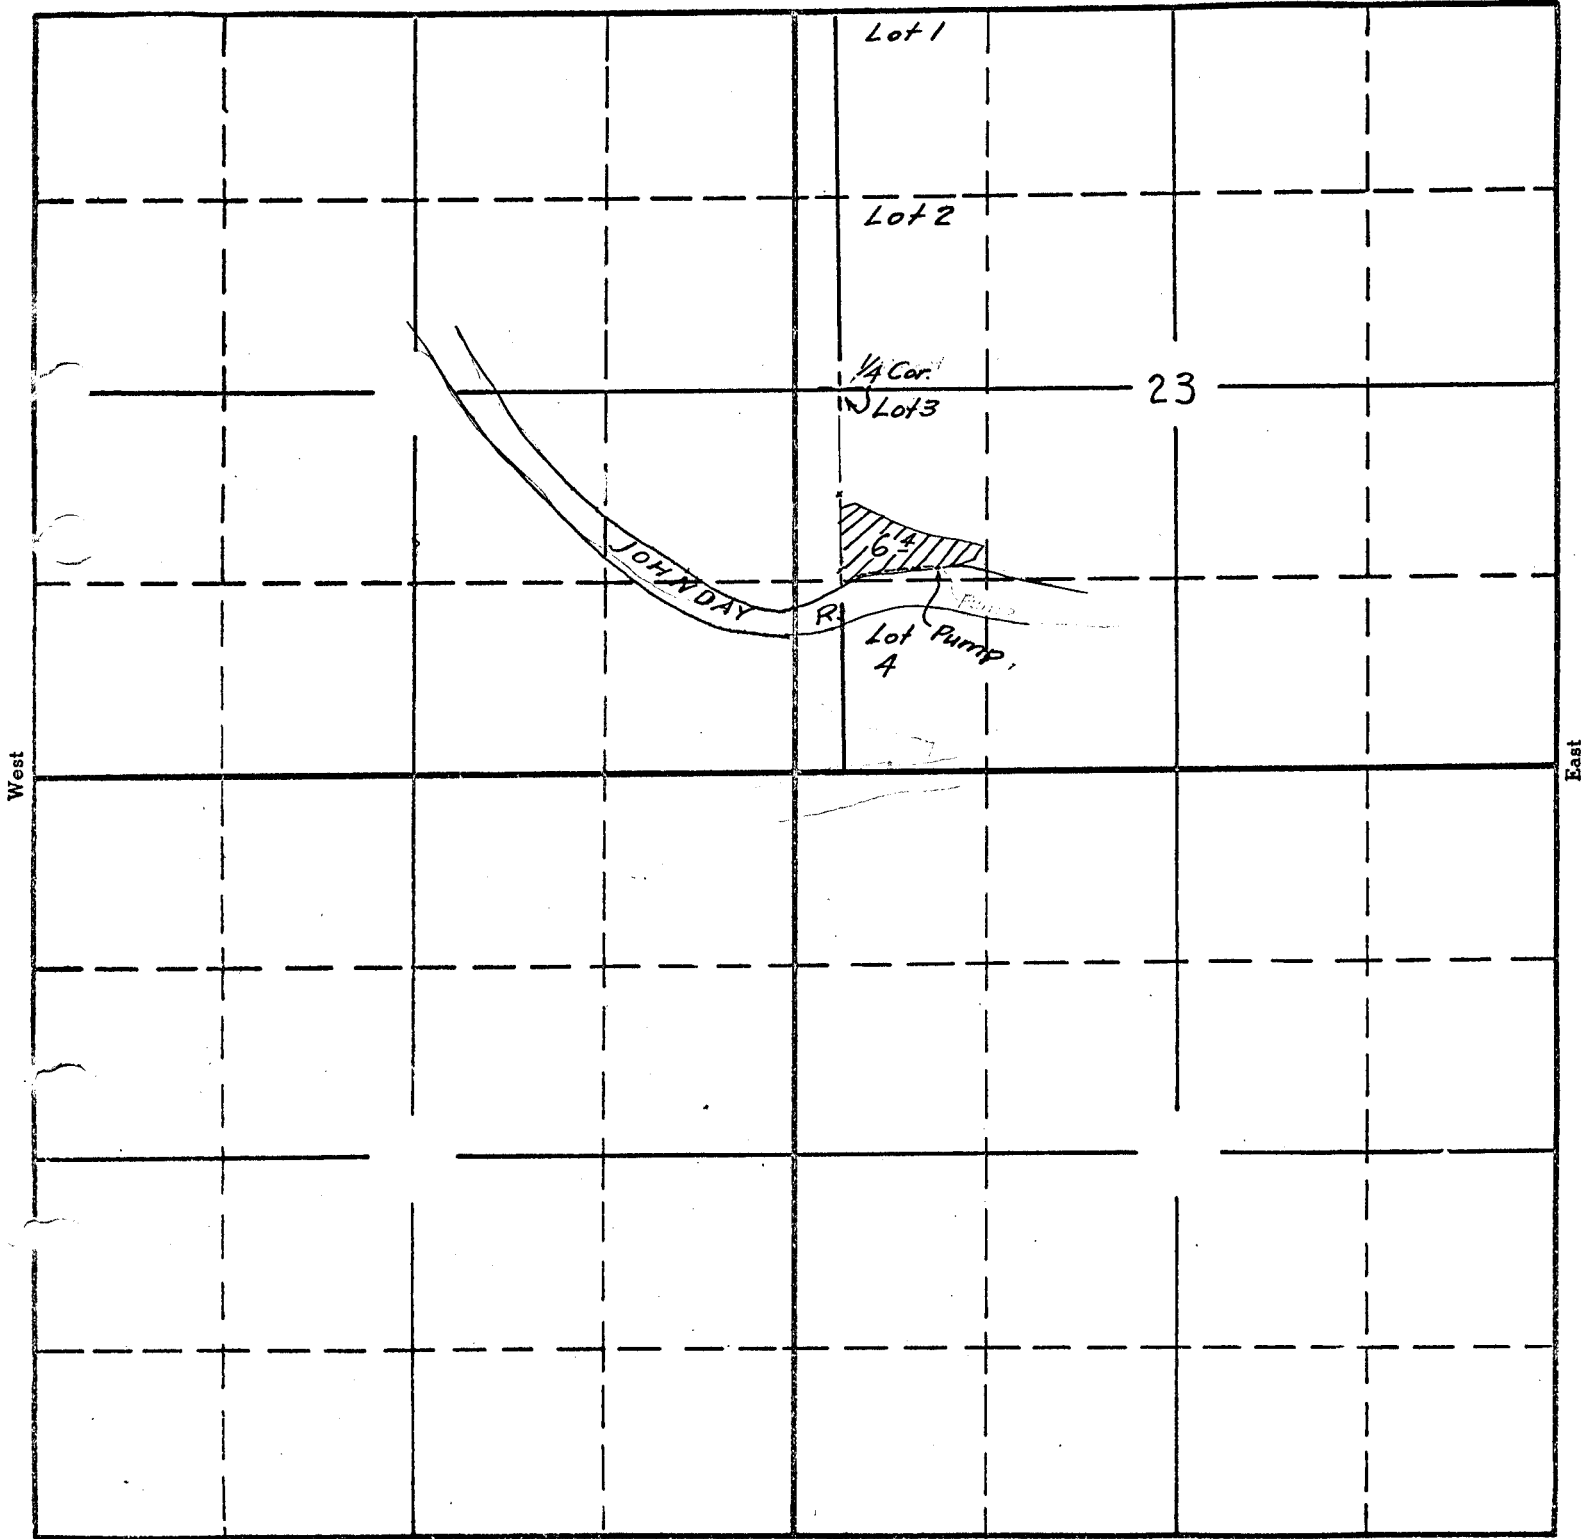

South

APPLICATION No. 16987

PERMIT No. 12736