



Township 2 N., Range

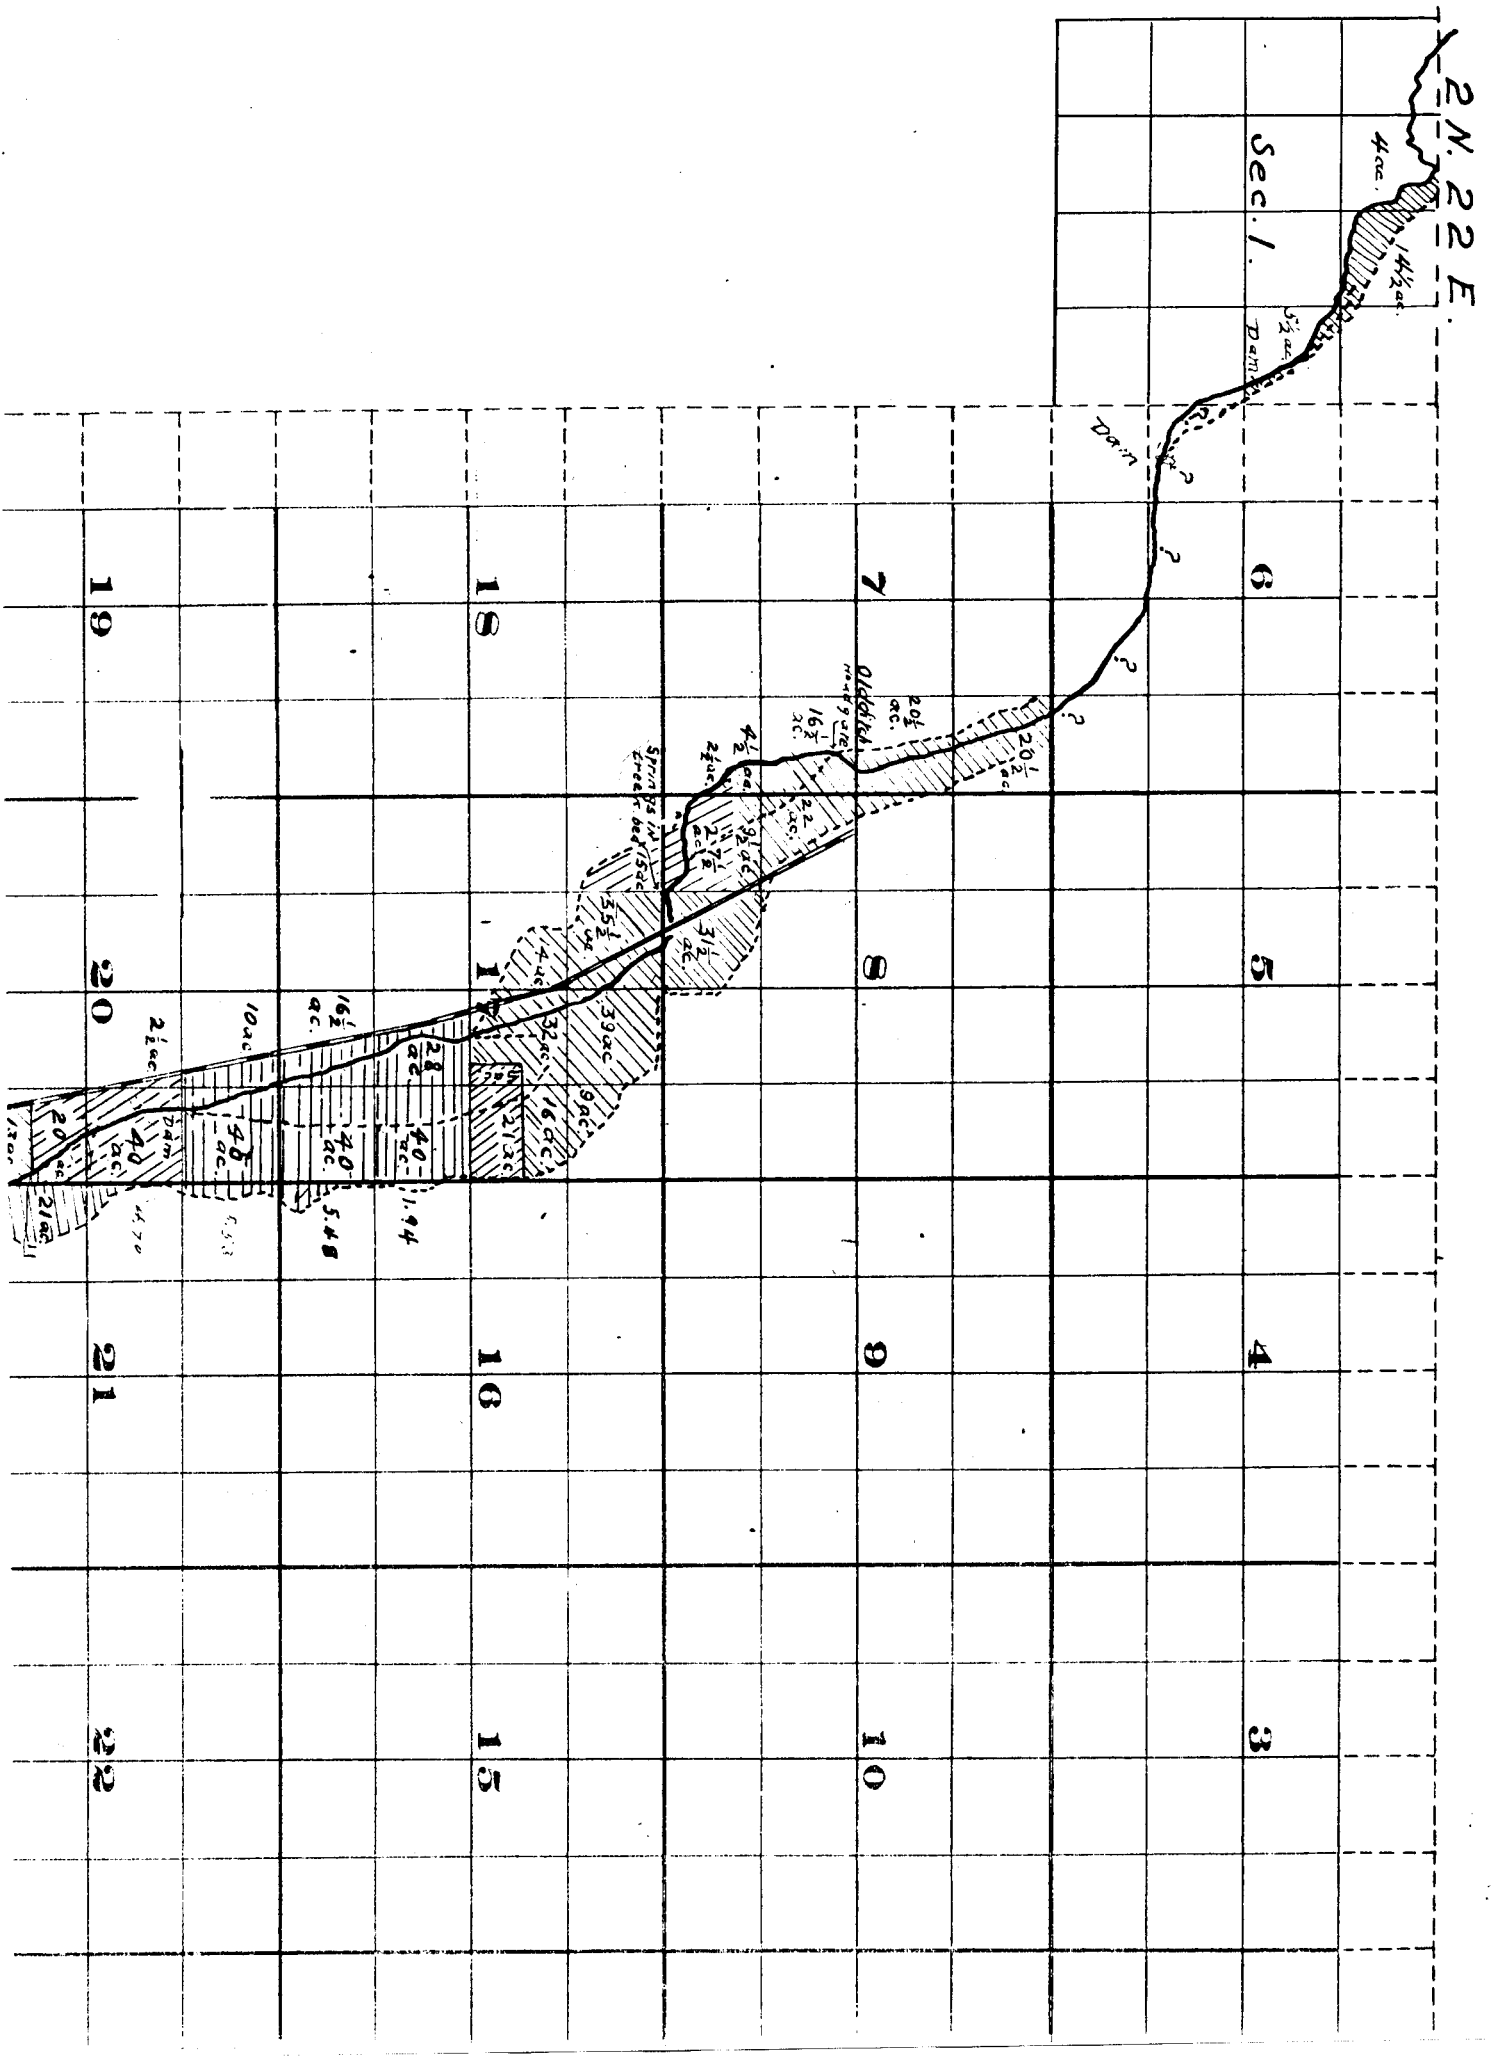

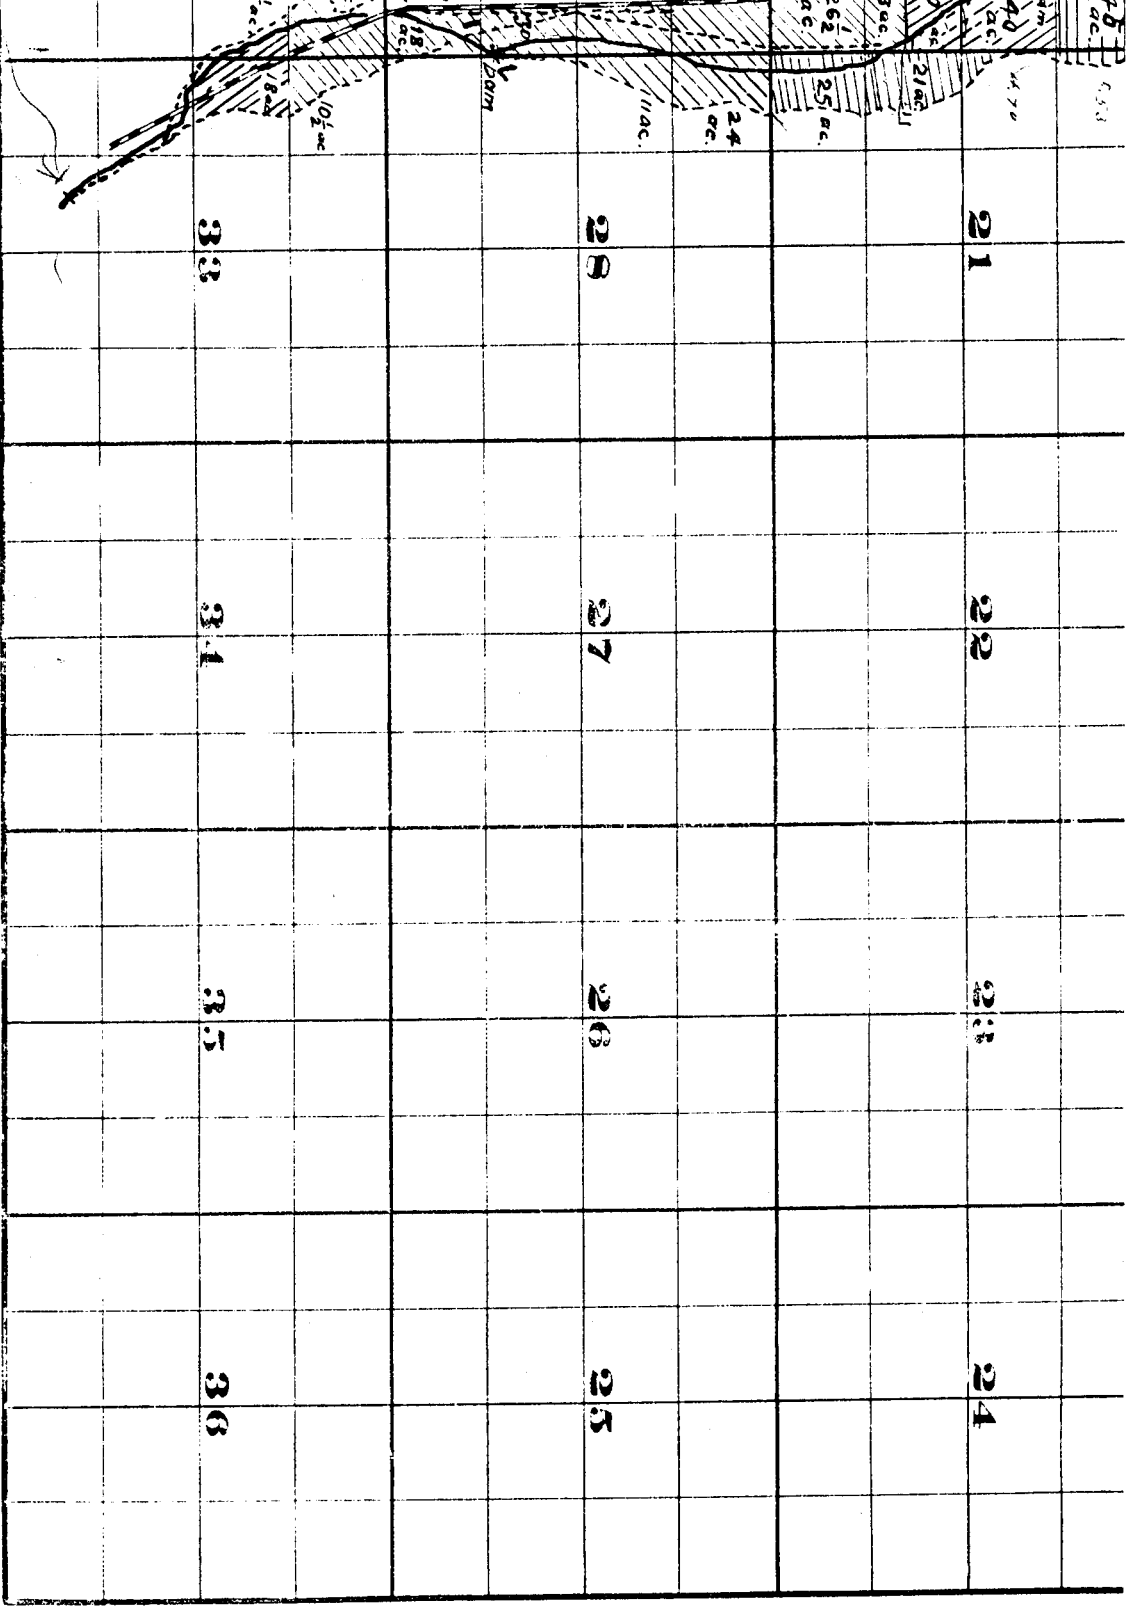


Willow Creek Adjudication.

July 1909.
Engineer.

July 14, 1909.

2 N. 22 E.
2 N. 23 E.