


SECTION

TOWNSHIP 8 S , RANGE 11 W , W. M.

North

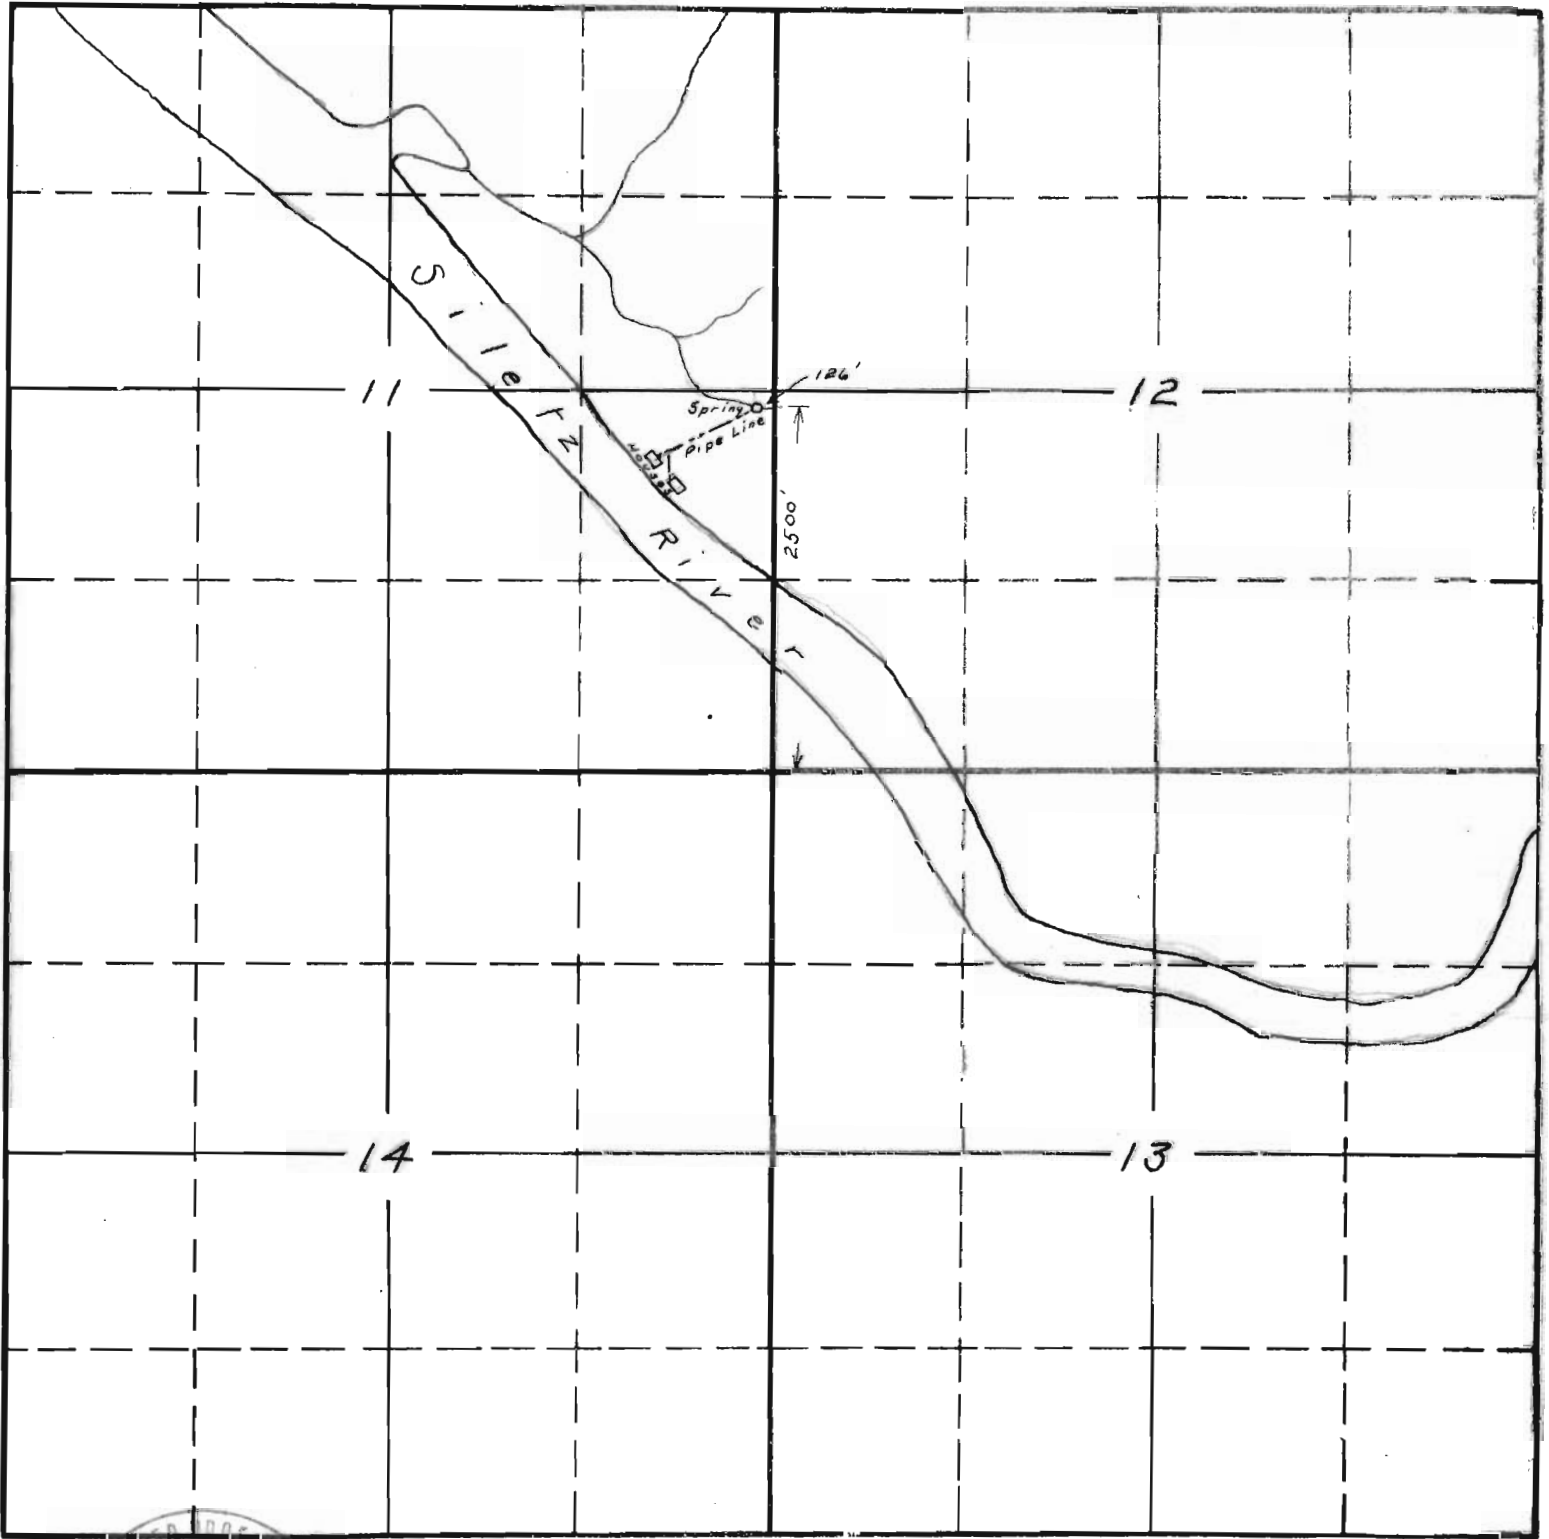

South



RECEIVED 18-20
 AUG 24 1987
 STATE ENGINEER
 SALEM, OREGON

17058 OK
 APPLICATION No. 17058
 PERMIT No. 12797